

Petron Malaysia Refining & Marketing BHD



Malaysia Petron ULSADO Project



P.O NO.	180183-18-104-001-A01
ITEM NO.	C-4303
ITEM DESCRIPTION	OFF GAS COMPRESSOR (DRY SCREW TYPE)
DOCUMENT TITLE	Wiring Connection Diagram
DOCUMENT NO.	VP-180183-18-104-C-4303-076
VENDOR	KOBELCO JAPAN

DOCUMENT TITLE : **Wiring Connection Diagram**

Document Approval Status	
Approval Status	Issue Purpose : FA, FR, FI, FF,AB ()
	A - APPROVED
	AAN - APPROVED AS NOTED
	RFC - RETURNED FOR CORRECTION
	R - REJECTED
Next Issue Status : FA, FR, FI, FF,AB ()	
SIGNED BY :	DATE
Daelim Permission to proceed or review taken on vendor document shall not relieve vendor from its responsibilities or liabilities under the purchase order.	

TOTAL 24 PAGES

C	Apr/08/19	FOR APPROVAL	H.F	T.S	T.S
B	Feb/14/19	FOR APPROVAL	H.F	T.S	T.S
A	Jan/07/18	FOR APPROVAL	H.F	T.S	T.S
REV.	DATE	DESCRIPTION	PREPARED	REVIEWED	APPROVED

DAELIM INDUSTRIAL CO., LTD/
PETRON MALAYSIA REFINING&MARKETING BHD

Wiring Connection Diagram

PROJECT	: Malaysia Petron ULSADO Project
SERVICES	: OFF GAS COMPRESSOR
UNIT ITEM No.	: C-4303
MODEL	: KS16SMZ
QUANTITY	: 1 set
VENDOR	: KOBE STEEL LTD.
KOBE JOB No	: 18-00432

THE DRAWING(S) AND THE INFORMATION CONTAINED HEREIN ARE THE PROPERTY OF KOBE STEEL, LTD. THEY SHALL NOT BE DISCLOSED, REPRODUCED OR USED IN ANY MANNER WITHOUT PRIOR WRITTEN CONSENT OF KOBE STEEL, LTD.

神戸製鋼所の了解なしに本図・書を複写したり、または第三者に貸与することは禁止されています

R2	Δ2 P1~13,14,16~18,20 Revised	602	2019/04/08	<i>T. Sato</i>	<i>gmi</i>	<i>PC</i>	<i>Pler</i>		
R1	Δ1 Revised	602	2019/02/14	D. S	H. F	T. S	T. S		
R0	ISSUE		2019/01/07	D. S	H. F	T. S	T. S		
REV NO.	REVISION NOTE		DATE	DRAWN	DESIGNED	CHECKED	APPROVED	REVIEWED	
ENGINEERING DEPT.									
REF.DWG.		CAREER			O.NO.		18-00432-K		
REF.O.NO.		CUSTOMER REF NO. :			S.NO.		03S-K73914		
PDM LINK	CAD	KOBE STEEL EST NO. :			T.NO.		B439494	REV	R2
ISSUED BY	MECHATRONICS SECTION	 KOBE STEEL, LTD. Machinery Business							
SECT. CODE	716A								

CONTENTS		PAGE
1. Instrument for Process Gas Line	P. 1
2. Instrument for Compressor Unit	P. 2
3. Instrument for L.O. Unit	P. 3-P. 4
4. Bently System for Compressor Unit	P. 5-P. 8
5. Bently System for Main Motor	P. 9-P. 11
6. Power Supply for Main Motor	P. 12
7. Power Supply for Auxiliary Motor	P. 13
8. Power Supply for Unit Control Panel	P. 14
9. Communication from DCS to UCP	P. 15
10. Interface Signal Between MCC and UCP	P. 16-P. 17
11. LCP (Switch Box and HMI)	P. 18-P. 19
12. Fluorescent Light	P. 20




1 A B C D E F G H I J K L M N O P Q R P. CONFIDENTIAL

PROCESS GAS LINE



2


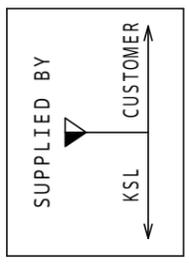


REVISION		REMARKS		TITLE		NO.	
R1		R4		OFF GAS COMPRESSOR		1	
R2		R5		WIRING CONNECTION DIAGRAM		PAGE	REV.
R3		R6					

KOBELCO | **KOBE STEEL, LTD.**
 Machinery Business

A B C D E F G H I J K L M N O P Q R P. CONFIDENTIAL




COMPRESSOR UNIT

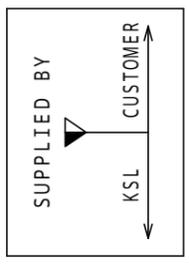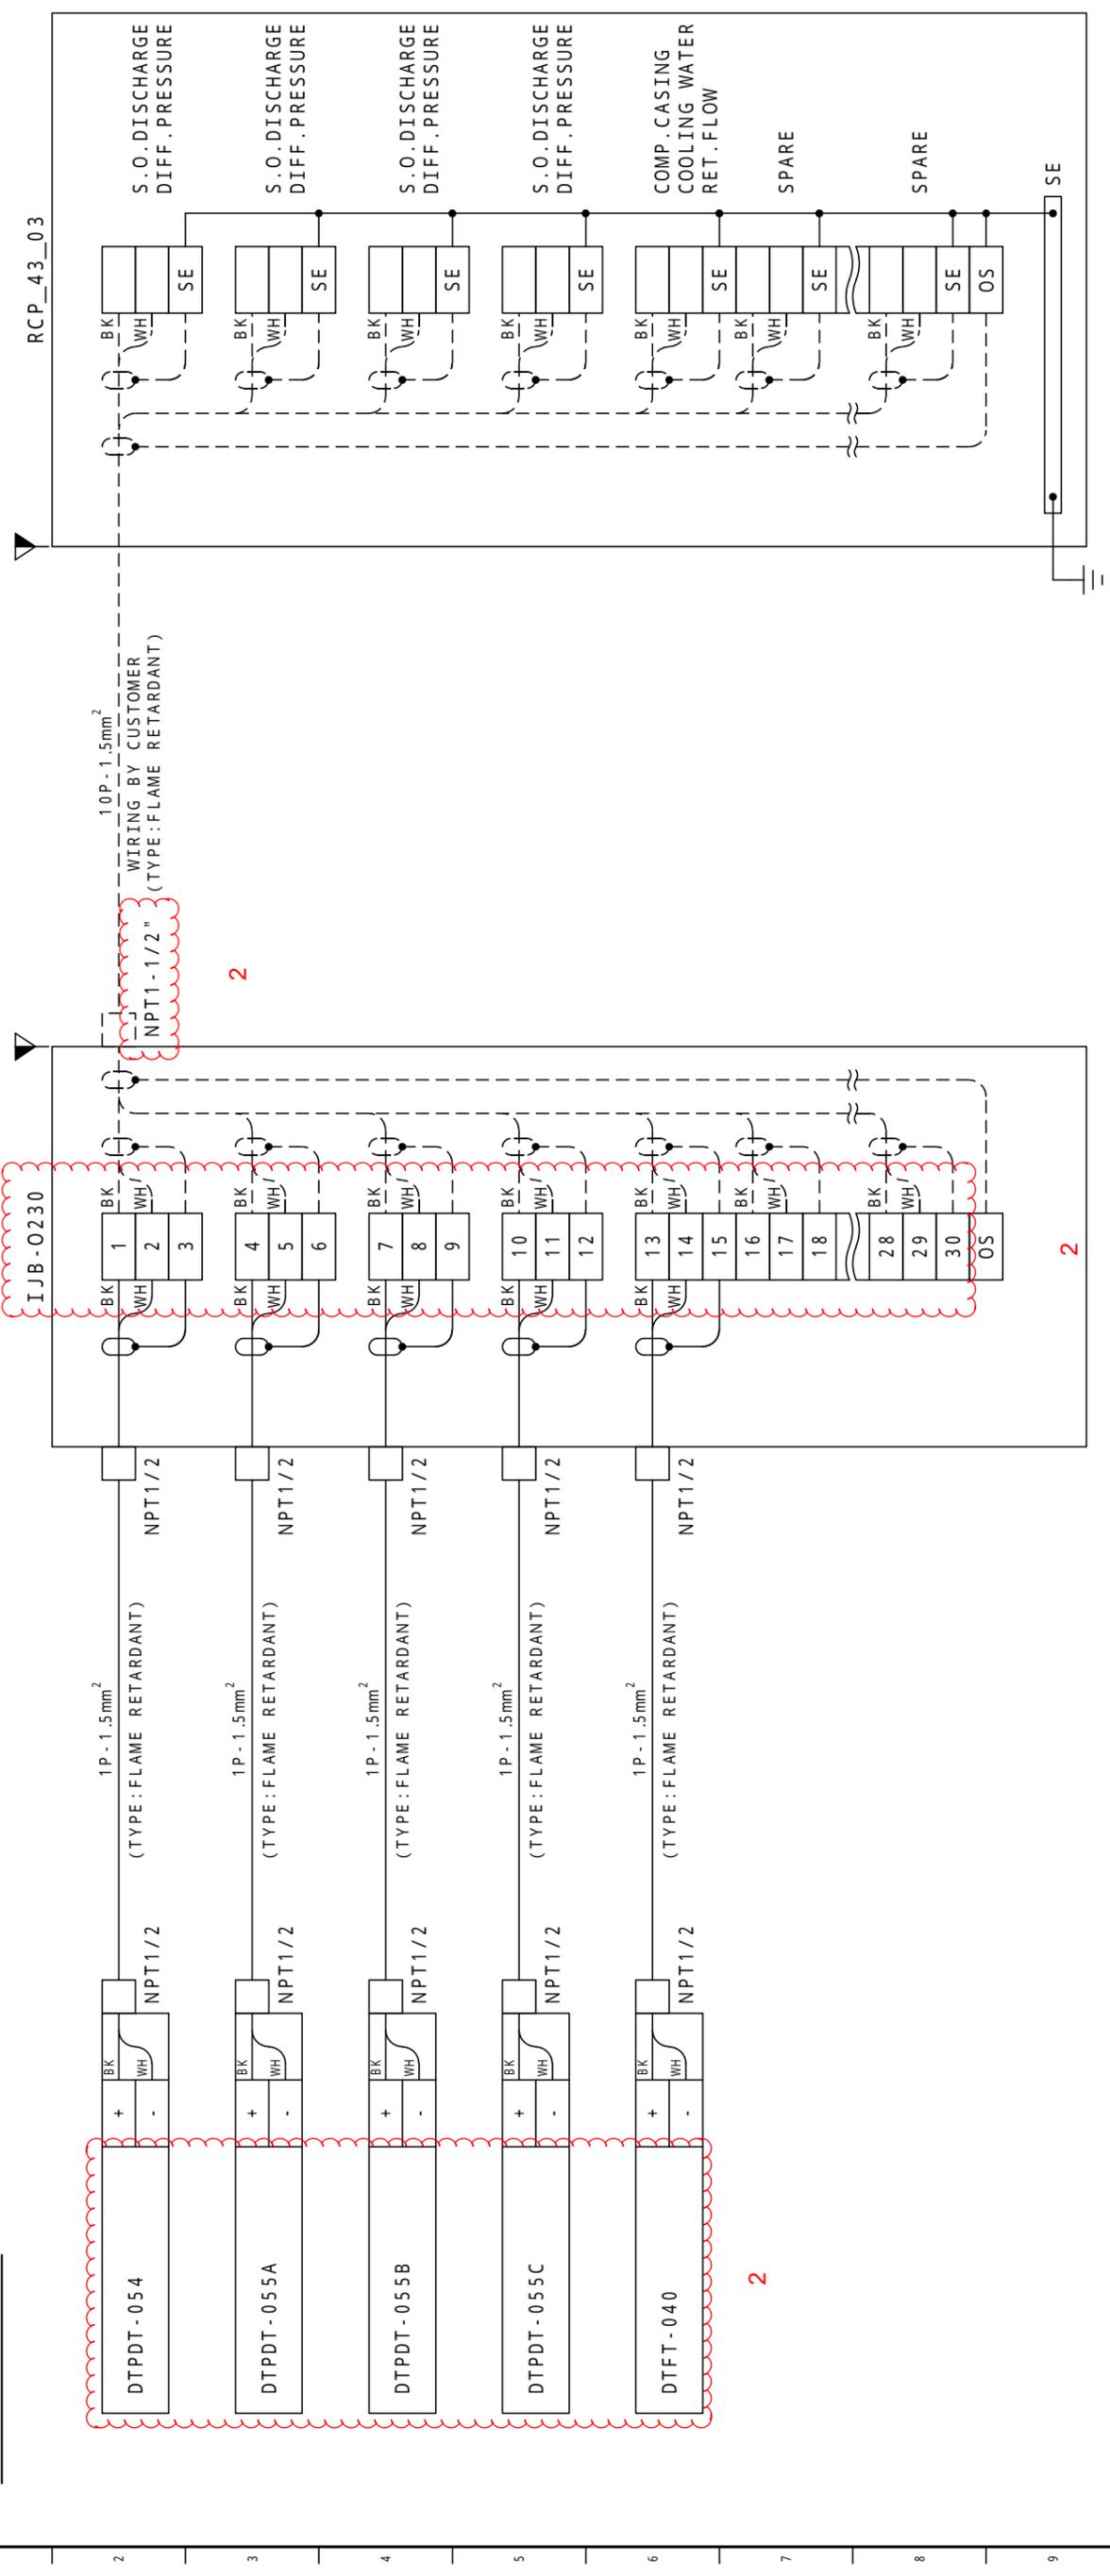

REVISION		REMARKS		TITLE		NO.	
R1		R4		OFF GAS COMPRESSOR		2	
R2		R5		WIRING CONNECTION DIAGRAM		PAGE	REV.
R3		R6		KOBELCO			
				Machinery Business			
				KOBELCO STEEL, LTD.			
				No.V: 図面#1800432K/B2WCA256 P. 2			

A B C D E F G H I J K L M N O P Q R P. CONFIDENTIAL


L.O. UNIT

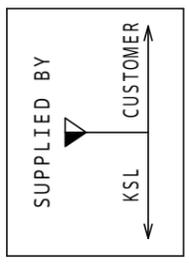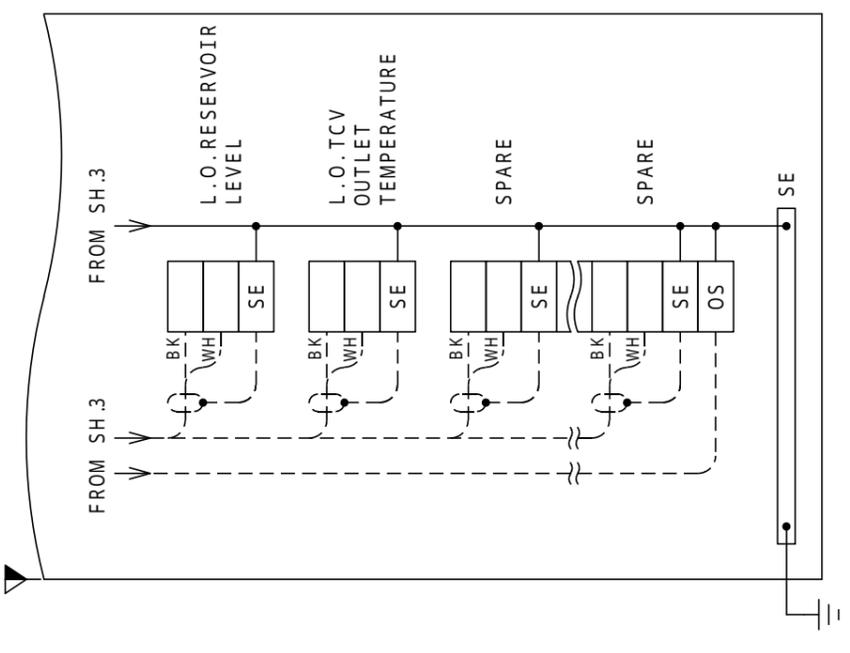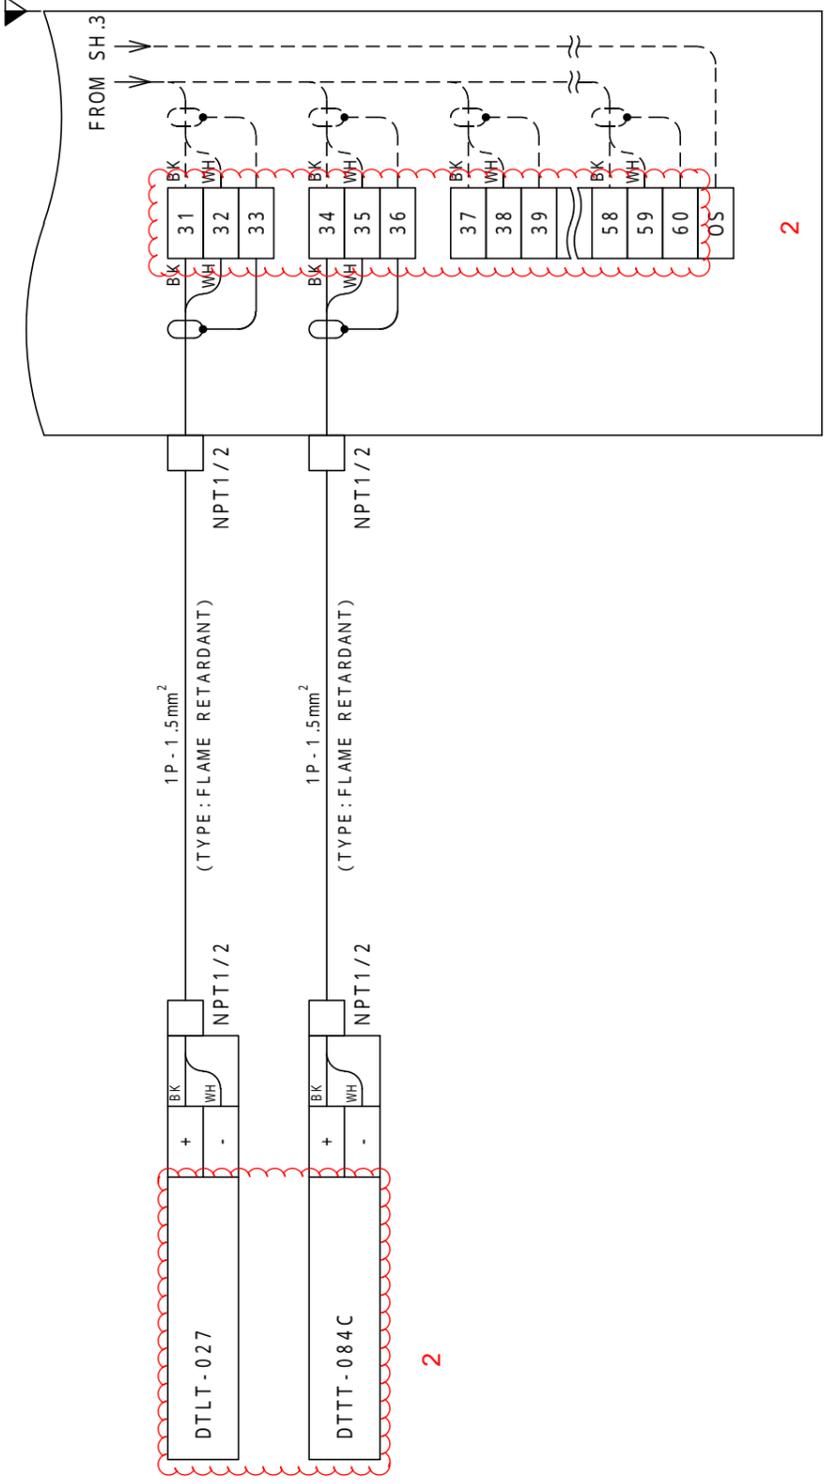

REVISION		R1	R4	REMARKS	
		R2	R5		
		R3	R6		
TITLE			NO.		
OFF GAS COMPRESSOR			4		
WIRING CONNECTION DIAGRAM			PAGE	REV.	

KOBELCO | **KOBE STEEL, LTD.**
 Machinery Business


A B C D E F G H I J K L M N O P Q R P. CONFIDENTIAL

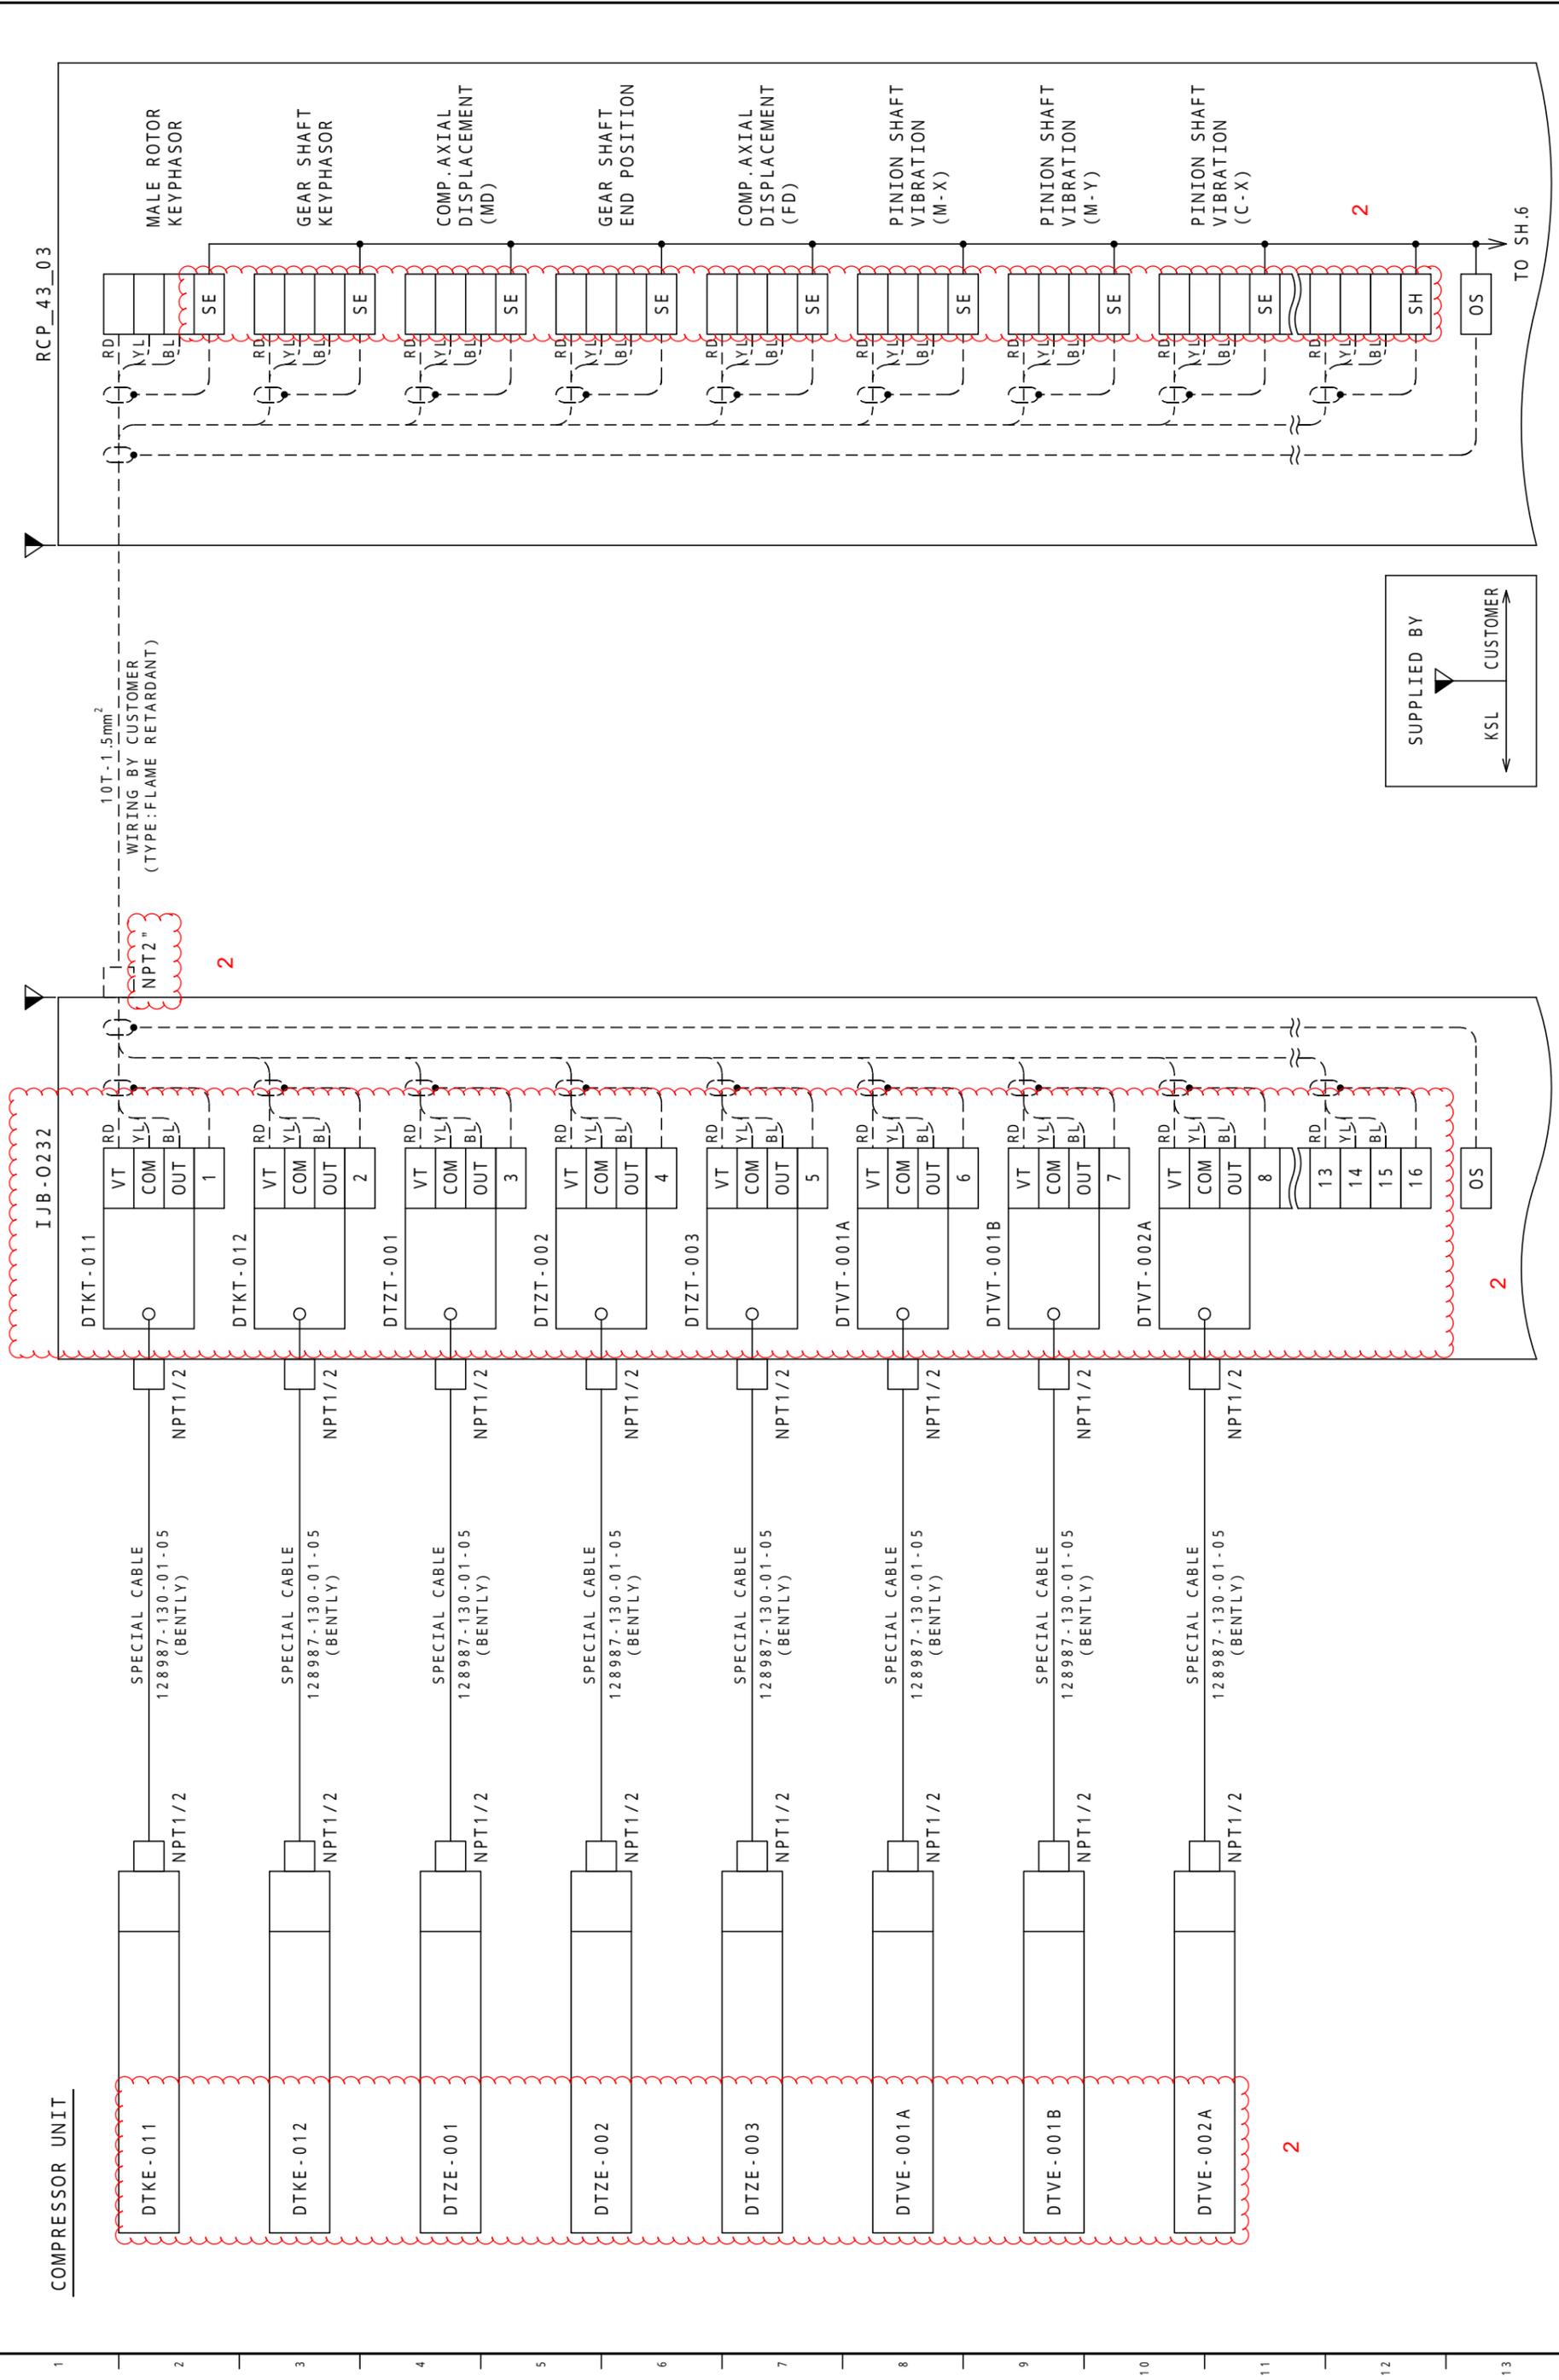

REVISION		REMARKS		TITLE		NO.	
R1		R4		OFF GAS COMPRESSOR		5	
R2		R5		WIRING CONNECTION DIAGRAM		PAGE	
R3		R6		Machinery Business		REV.	
				No. V: 堀内 18040432KY B2WCA256 P. 5			

CONFIDENTIAL



COMPRESSOR UNIT

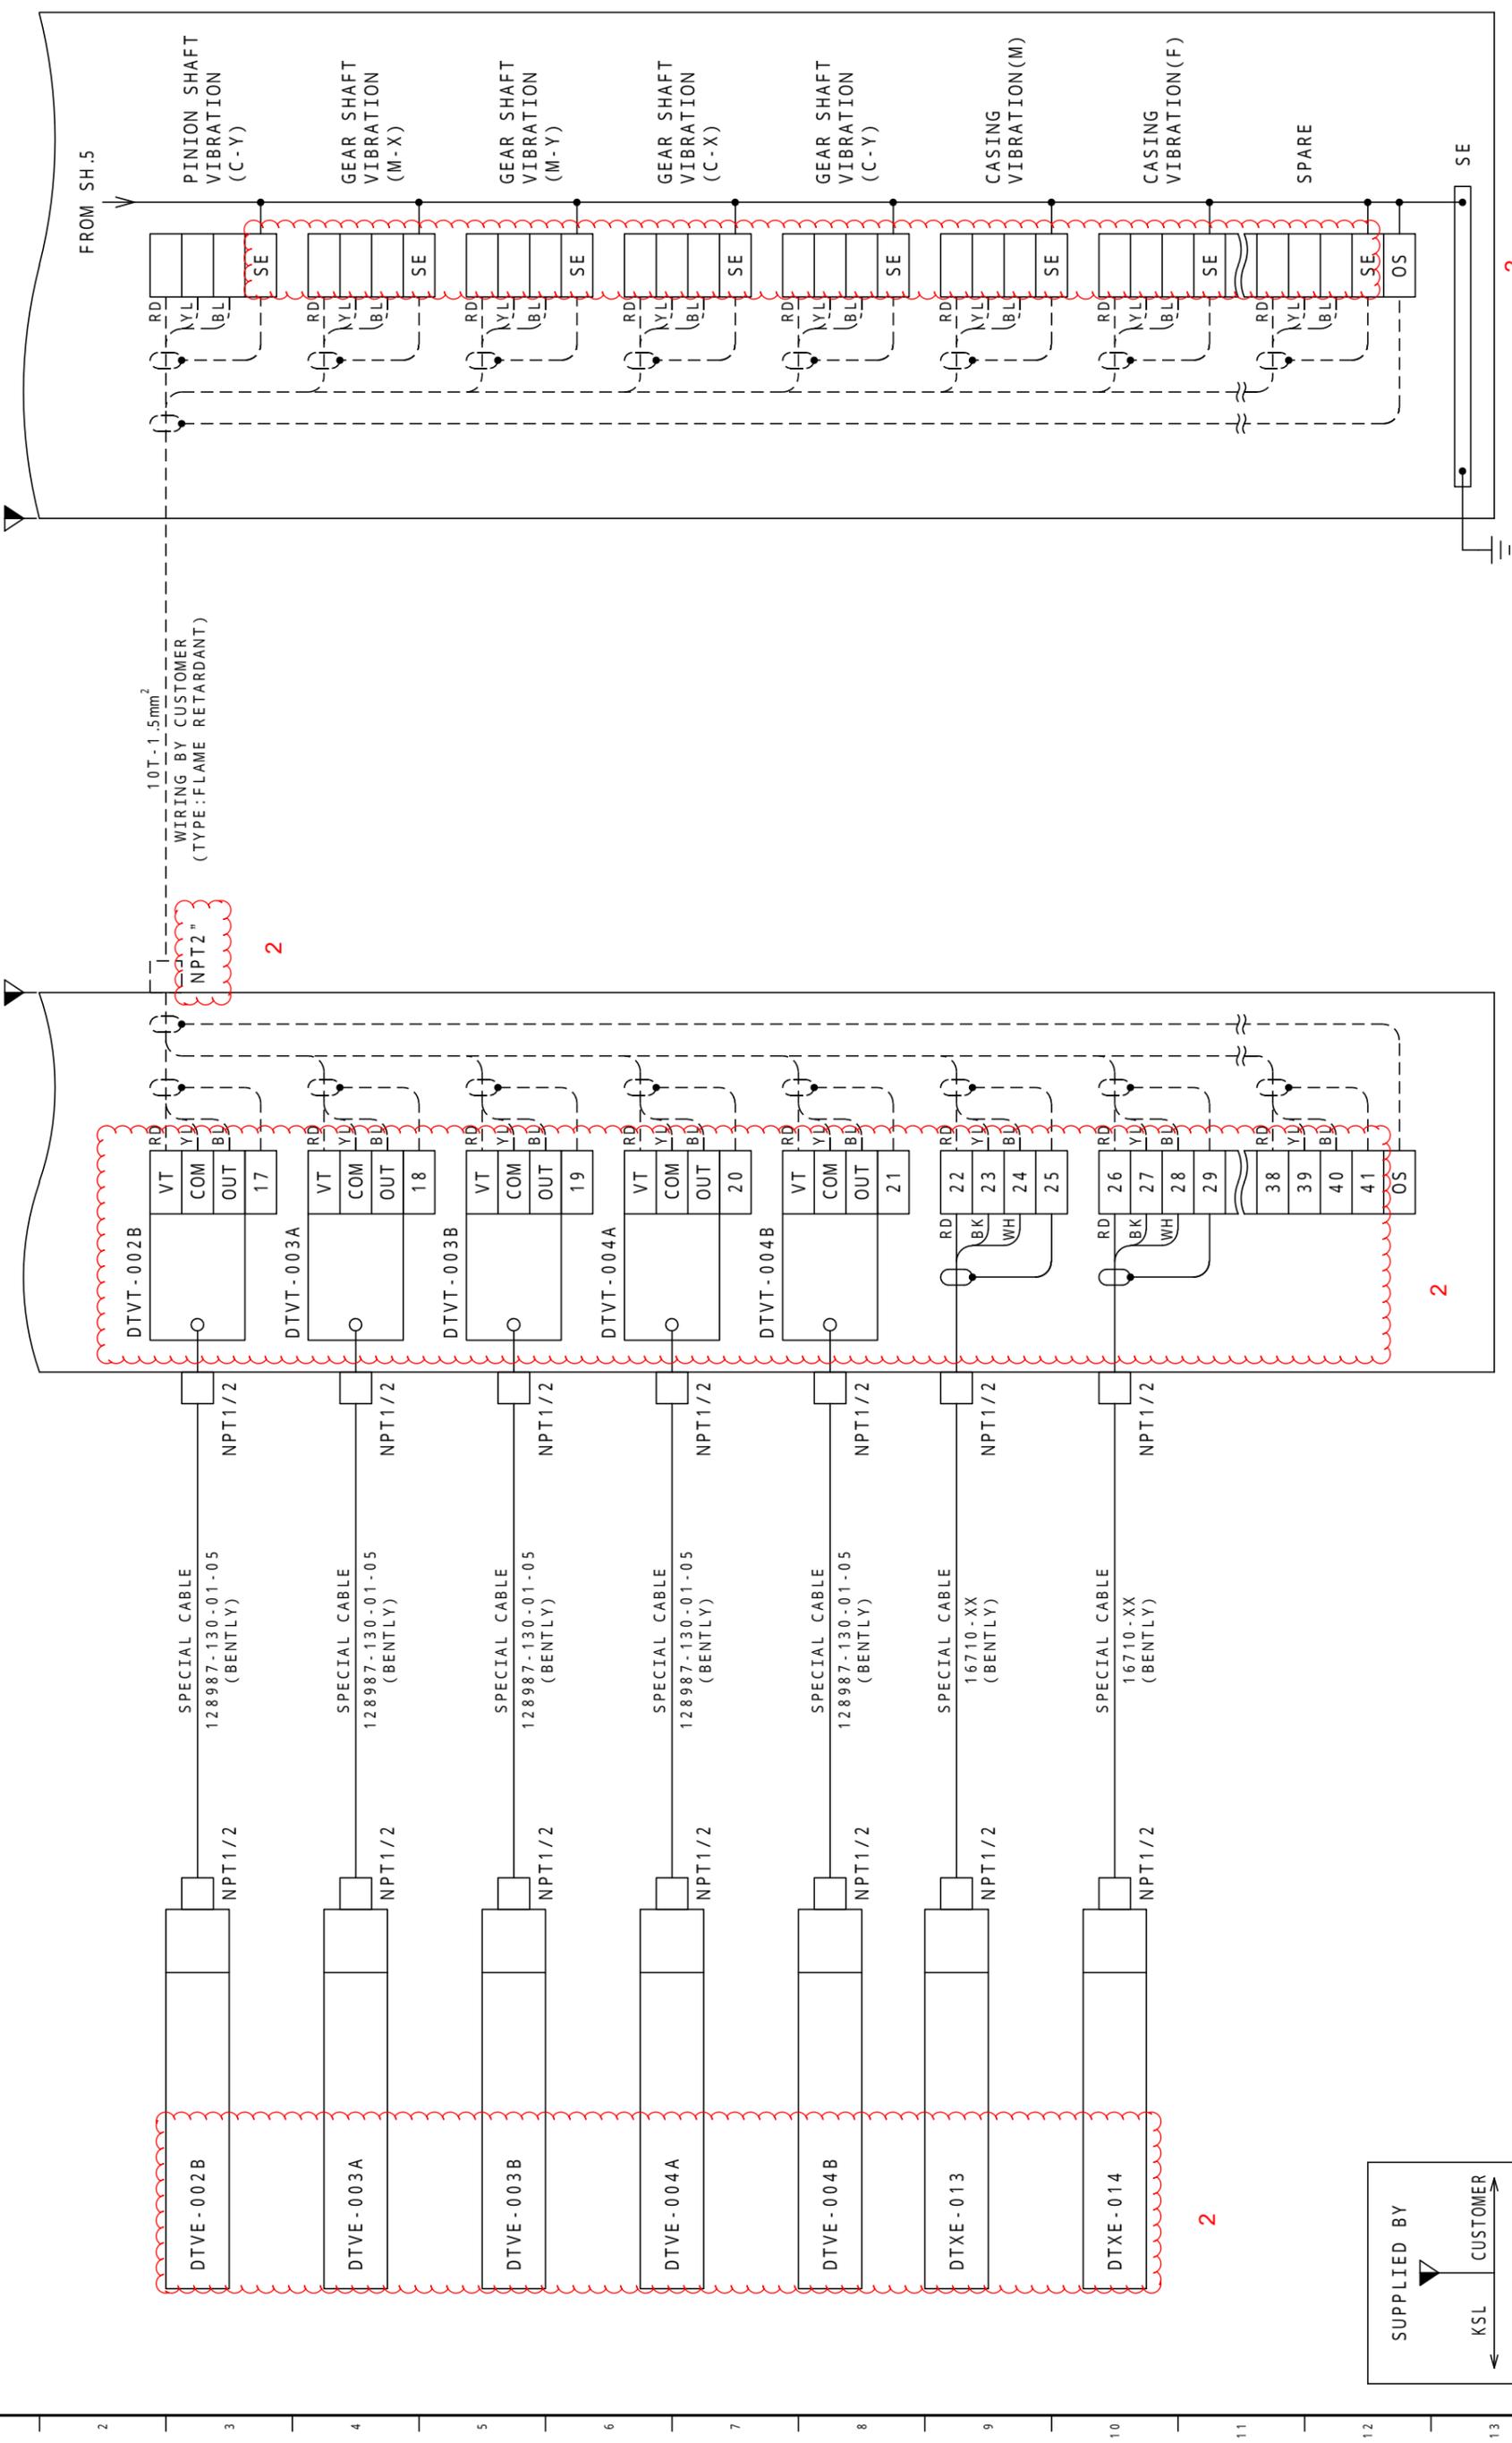

REVISION		REMARKS		TITLE		NO.	
R1		R4		OFF GAS COMPRESSOR		6	
R2		R5		WIRING CONNECTION DIAGRAM		PAGE	
R3		R6		Machinery Business		REV.	
				KOBELCO		No. V: 裡面 1800432KY B2WCA256 P. 6	

1 A B C D E F G H I J K L M N O P Q R P. CONFIDENTIAL



COMPRESSOR UNIT

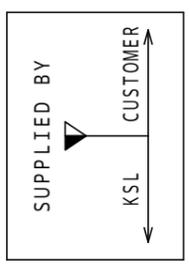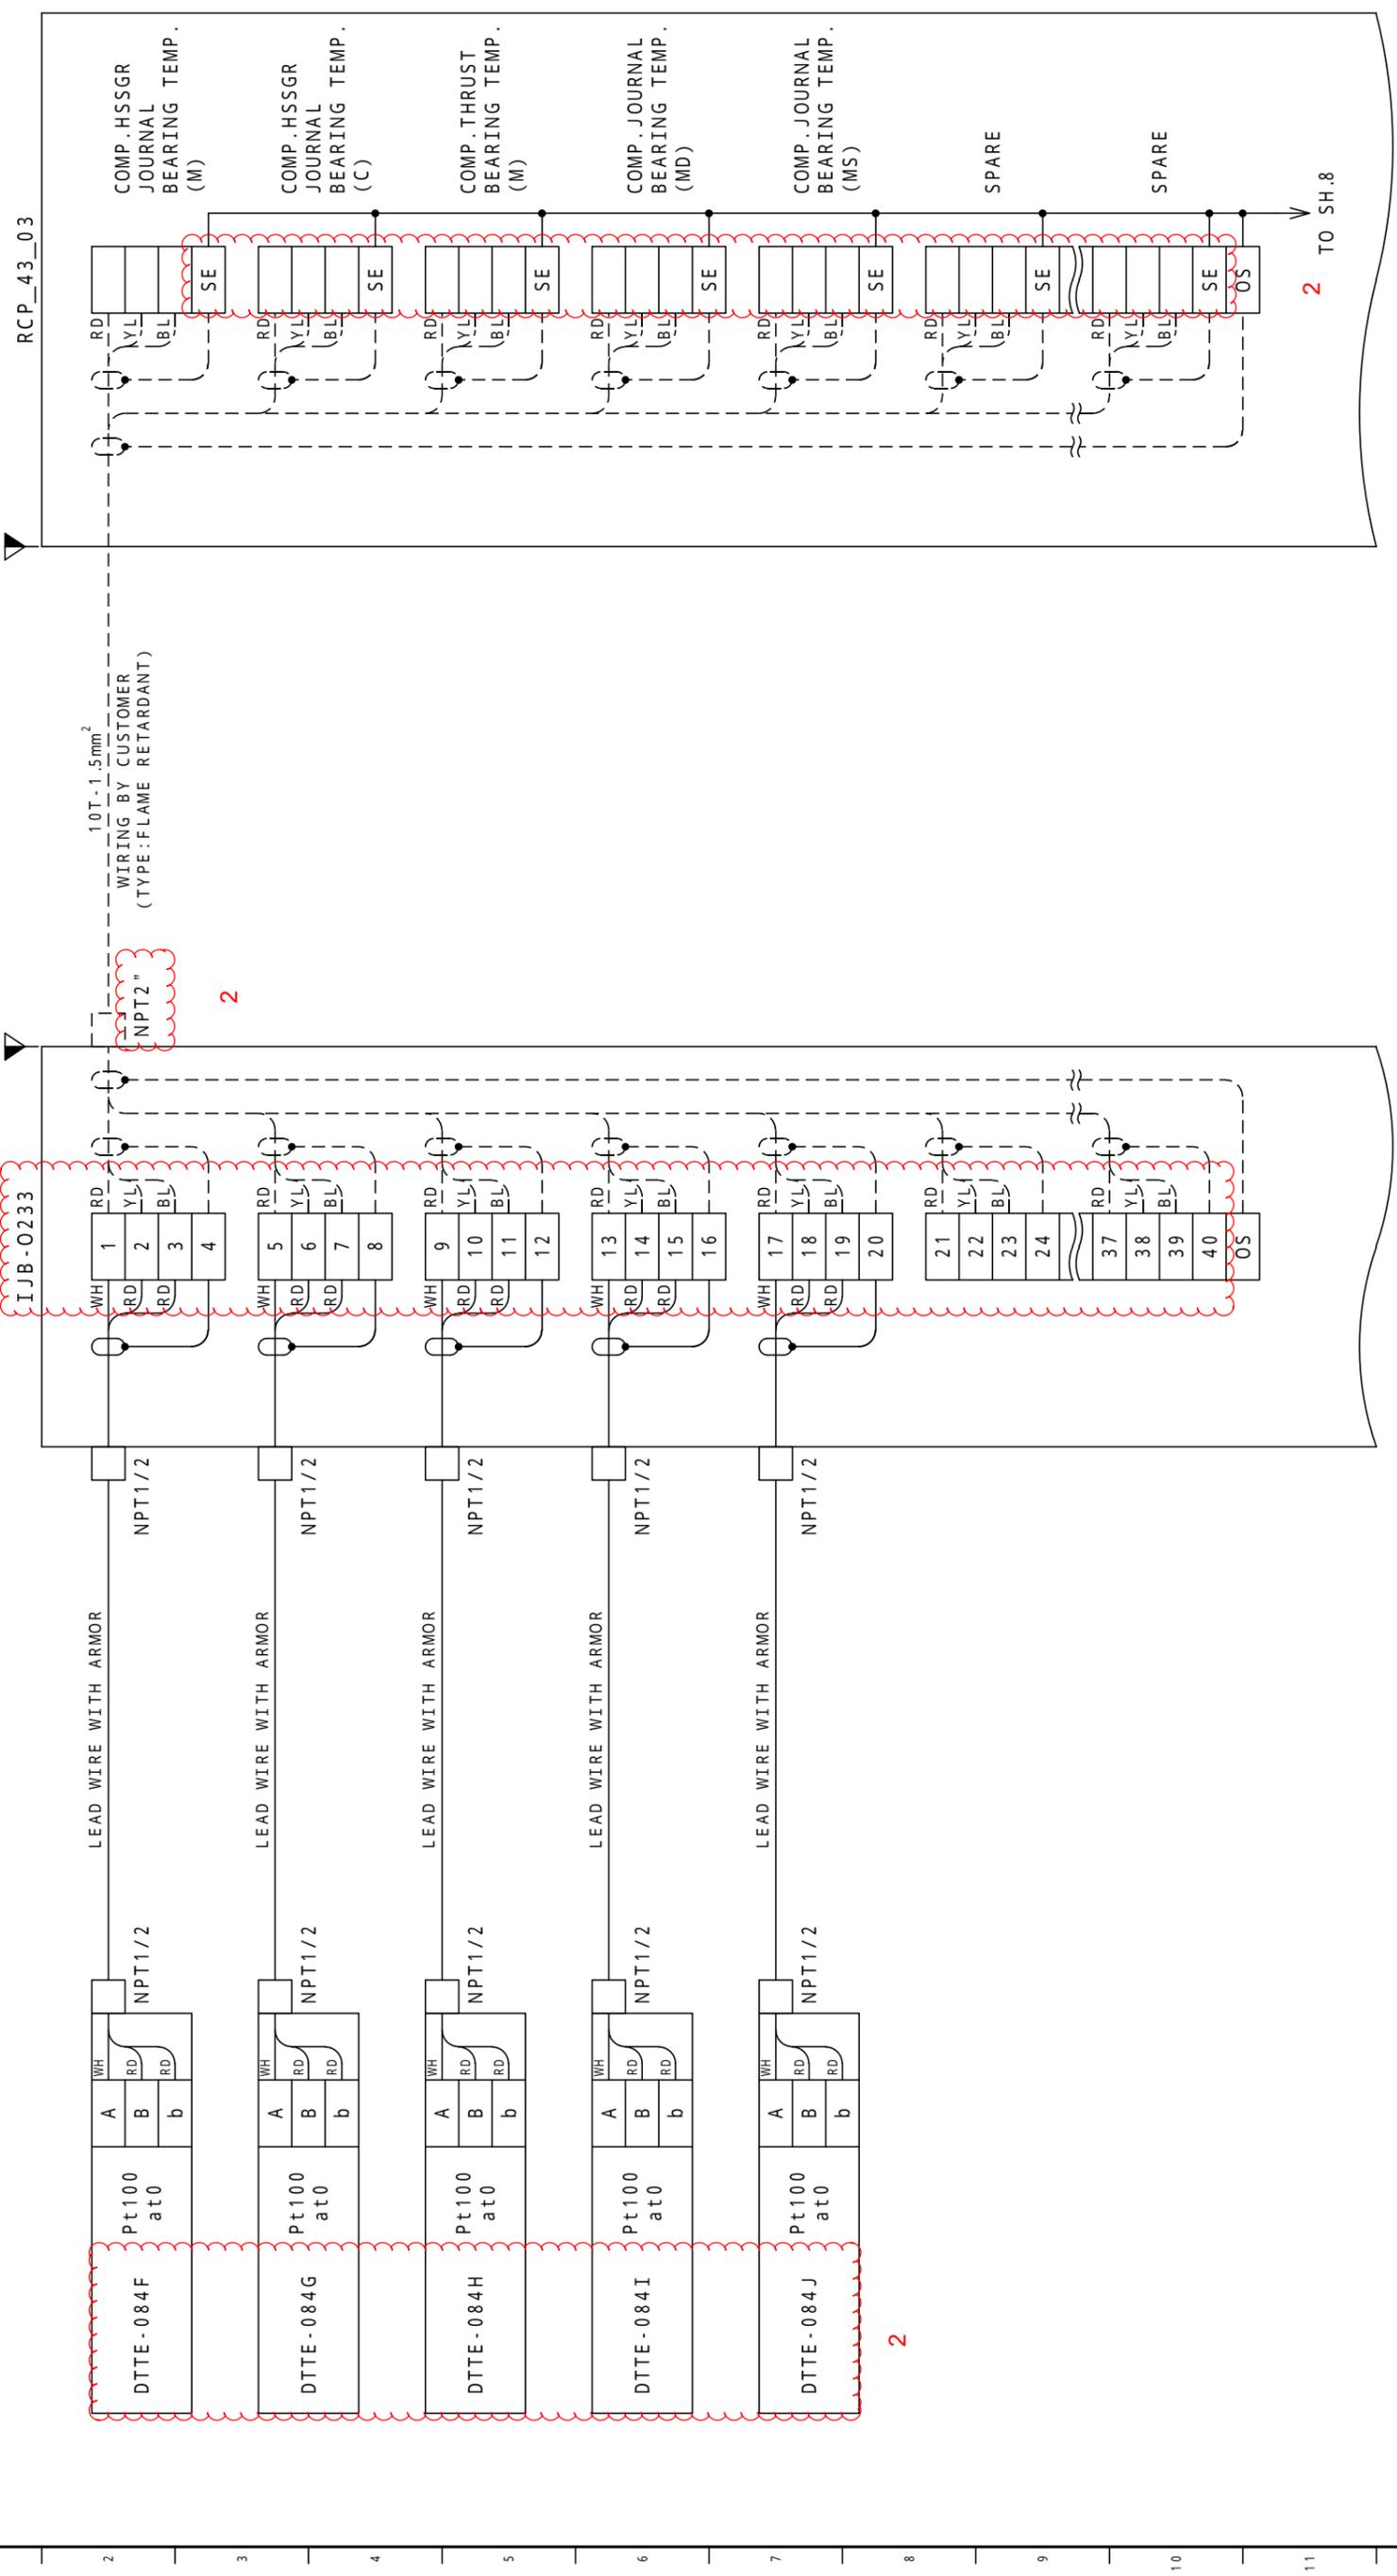

REVISION	R1		REMARKS	TITLE		NO.	7
	R2			OFF GAS COMPRESSOR		PAGE	7
	R3			WIRING CONNECTION DIAGRAM		REV.	
				KOBE STEEL, LTD. Machinery Business		No. V. 図面 1800432KY B2WCA256 P. 7	



1 A B C D E F G H I J K L M N O P Q P. CONFIDENTIAL

COMPRESSOR UNIT

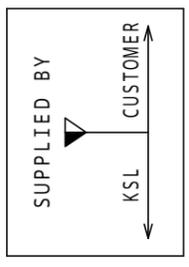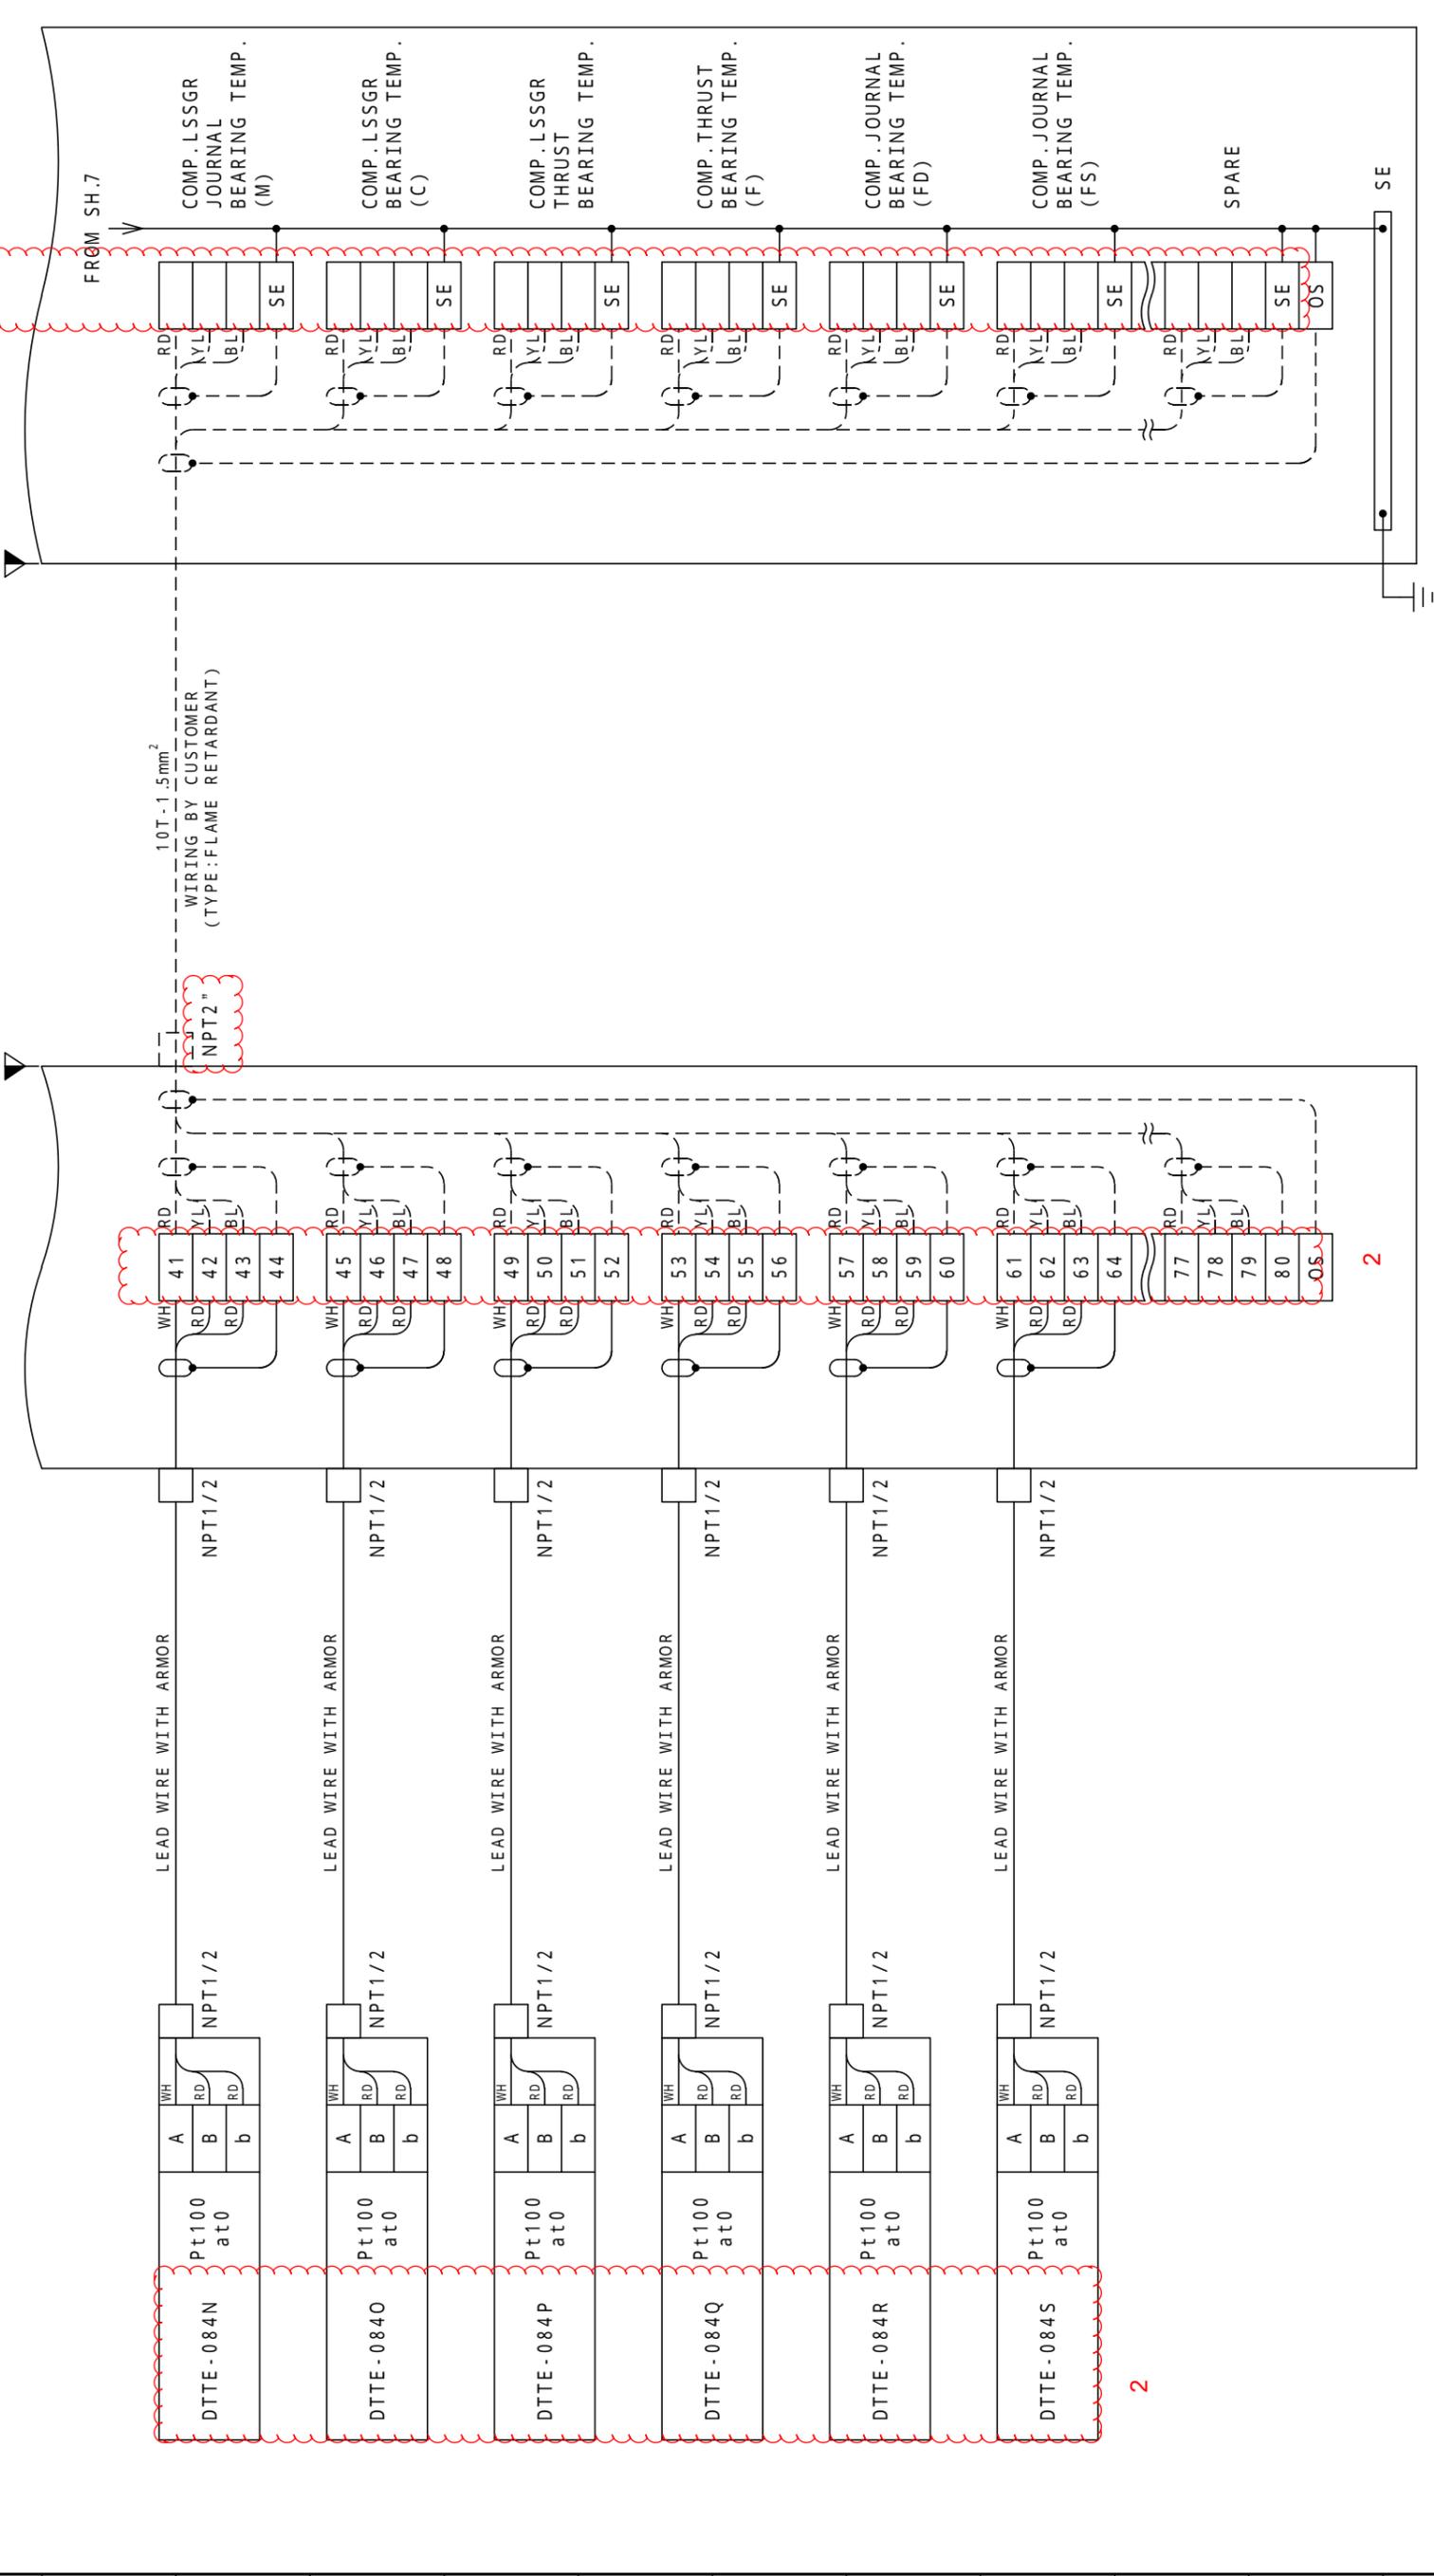



REVISION		REMARKS		TITLE		NO.	
R1		R4		OFF GAS COMPRESSOR		8	
R2		R5		WIRING CONNECTION DIAGRAM		PAGE	REV.
R3		R6		Machinery Business			
				KOBELCO		KOBELCO STEEL, LTD.	
				Machinery Business		OFF GAS COMPRESSOR	
				WIRING CONNECTION DIAGRAM		WIRING CONNECTION DIAGRAM	

A B C D E F G H I J K L M N O P Q R P. CONFIDENTIAL

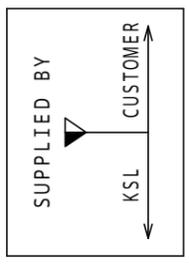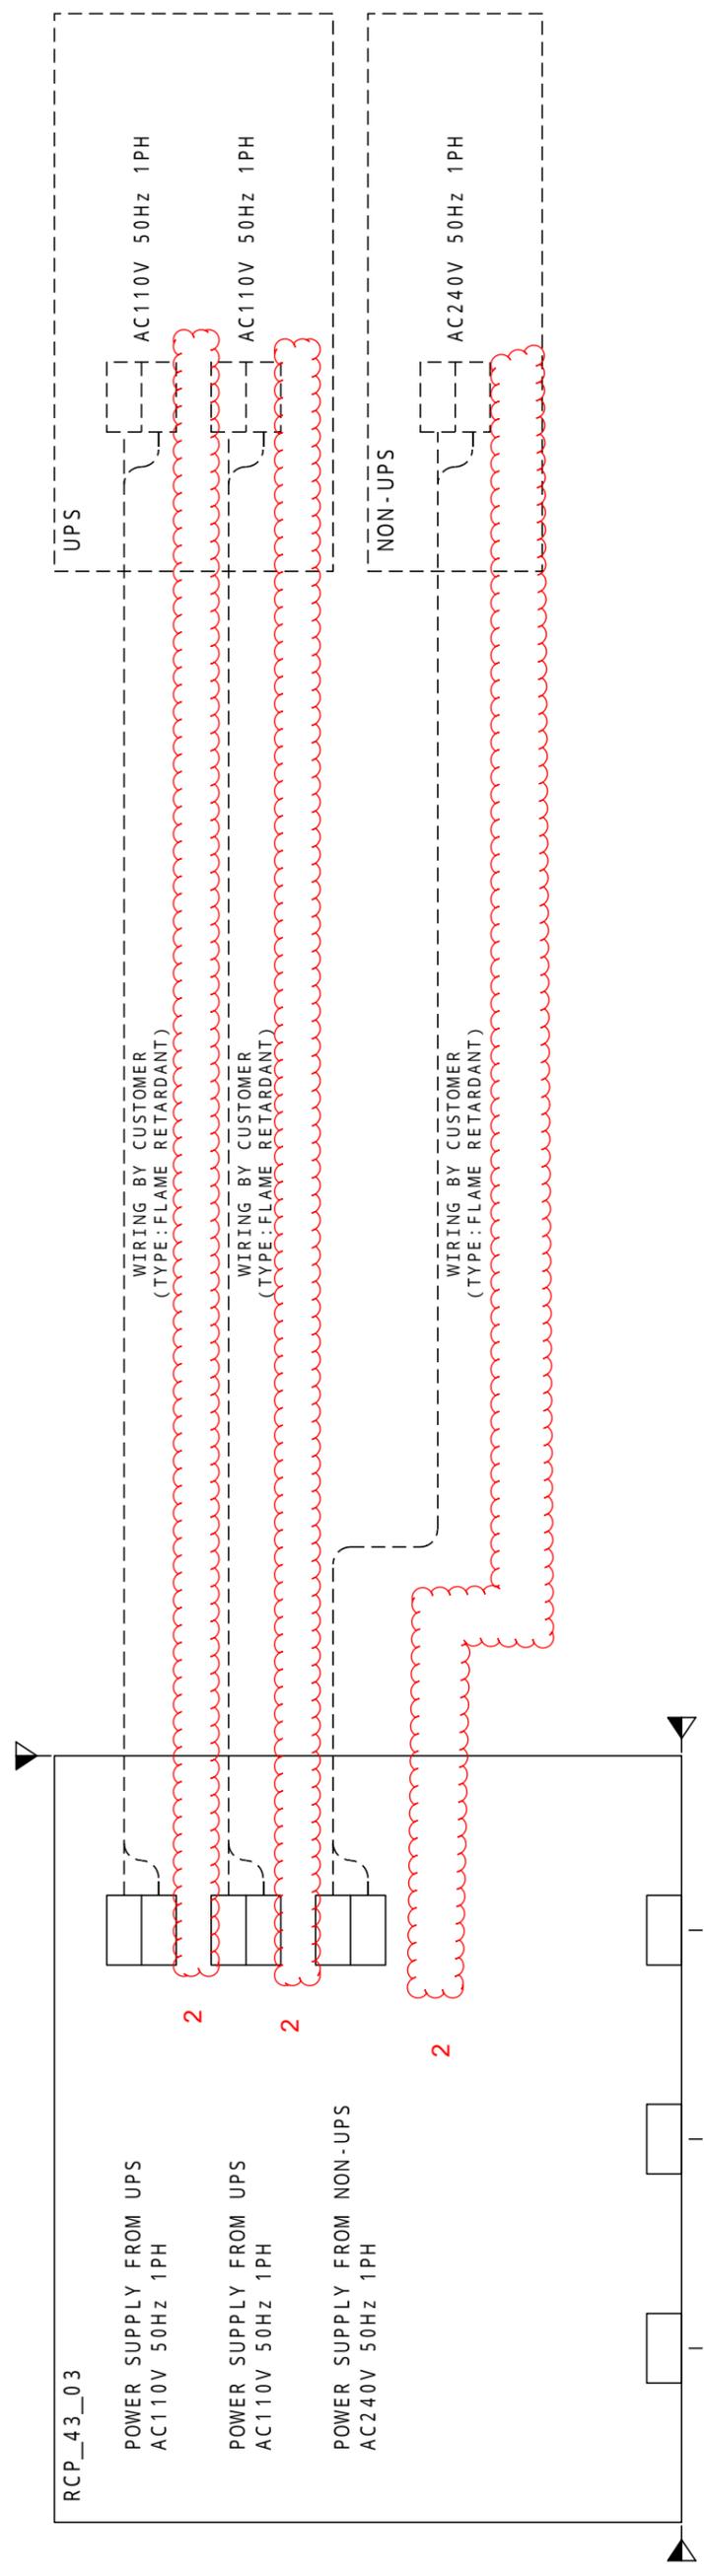

REVISION		REMARKS		TITLE		NO.	
R1		R4		OFF GAS COMPRESSOR		14	
R2		R5		WIRING CONNECTION DIAGRAM		PAGE	REV.
R3		R6					
				KOBE STEEL, LTD. Machinery Business			
N.O.V.: 図面#1800432K/B2WCA256 P. 14							



A B C D E F G H I J K L M N O P Q R P. CONFIDENTIAL

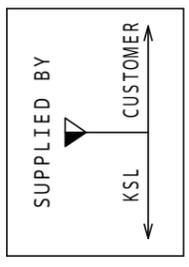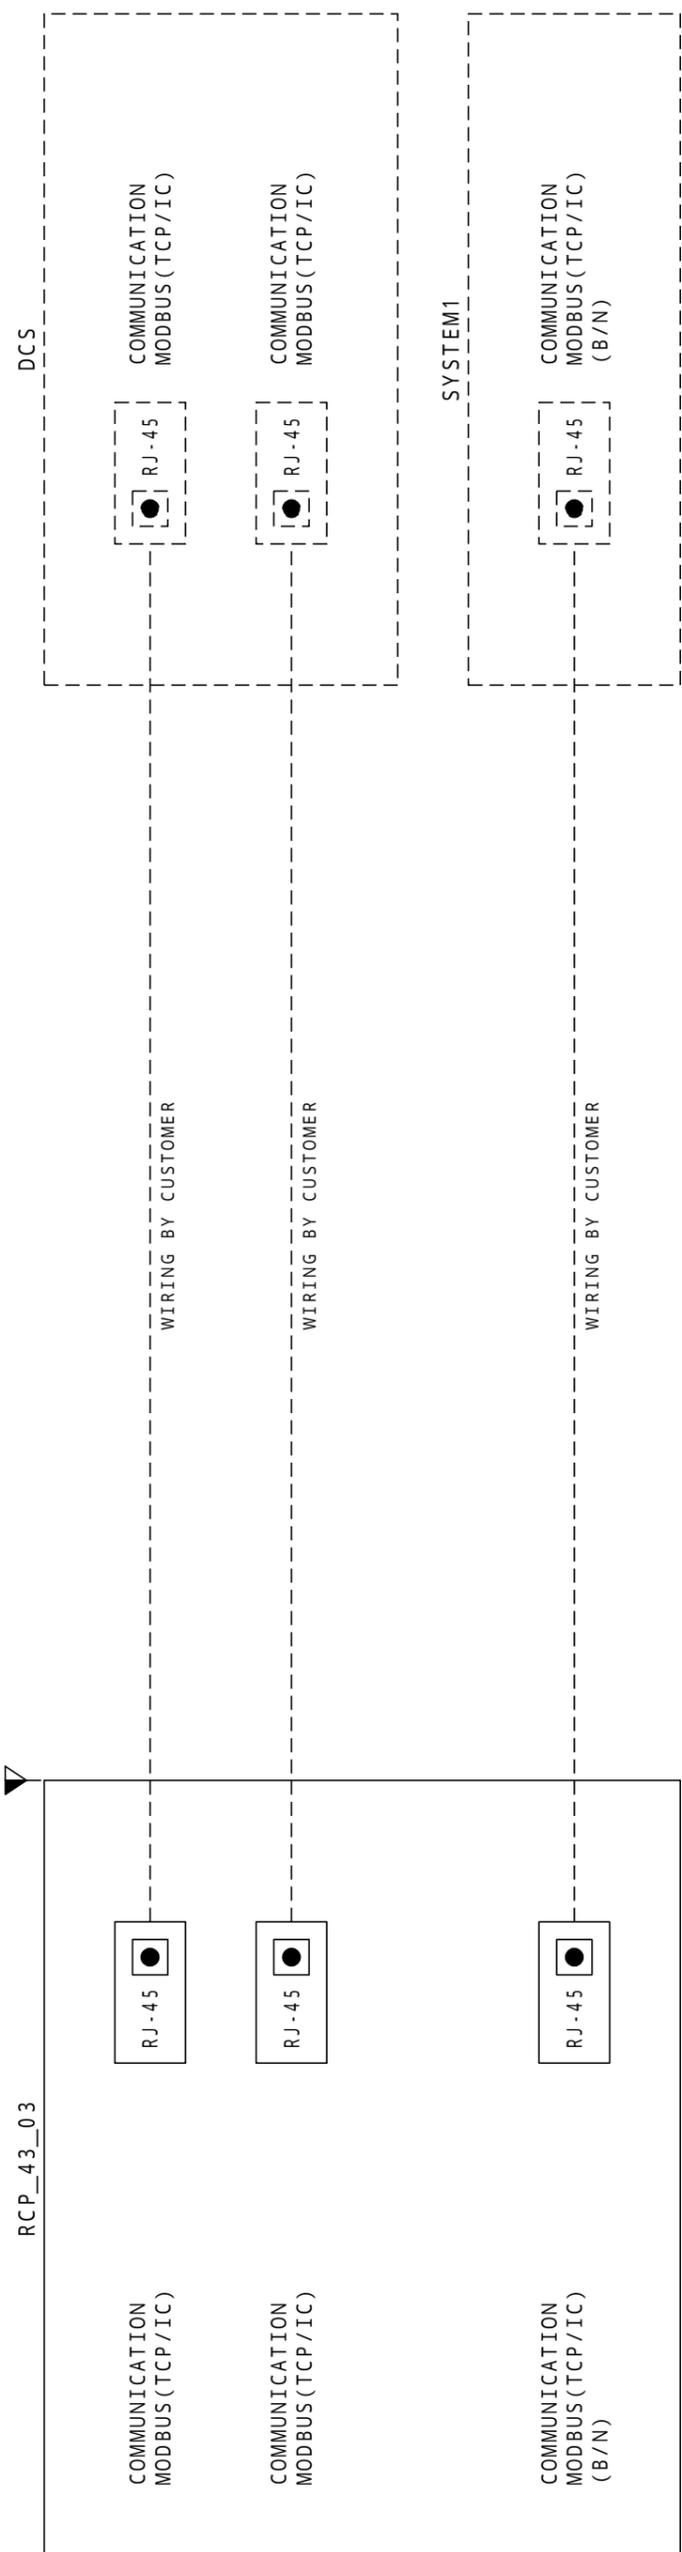

REVISION	R1					REMARKS	KOBE STEEL, LTD. Machinery Business	TITLE OFF GAS COMPRESSOR WIRING CONNECTION DIAGRAM	NO.	15
	R2								PAGE	15
	R3								REV.	


P. CONFIDENTIAL Q P P O M N L K J I H G F E D C B A

RCP_43_03

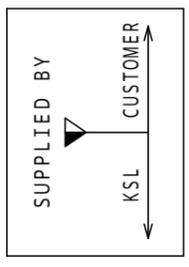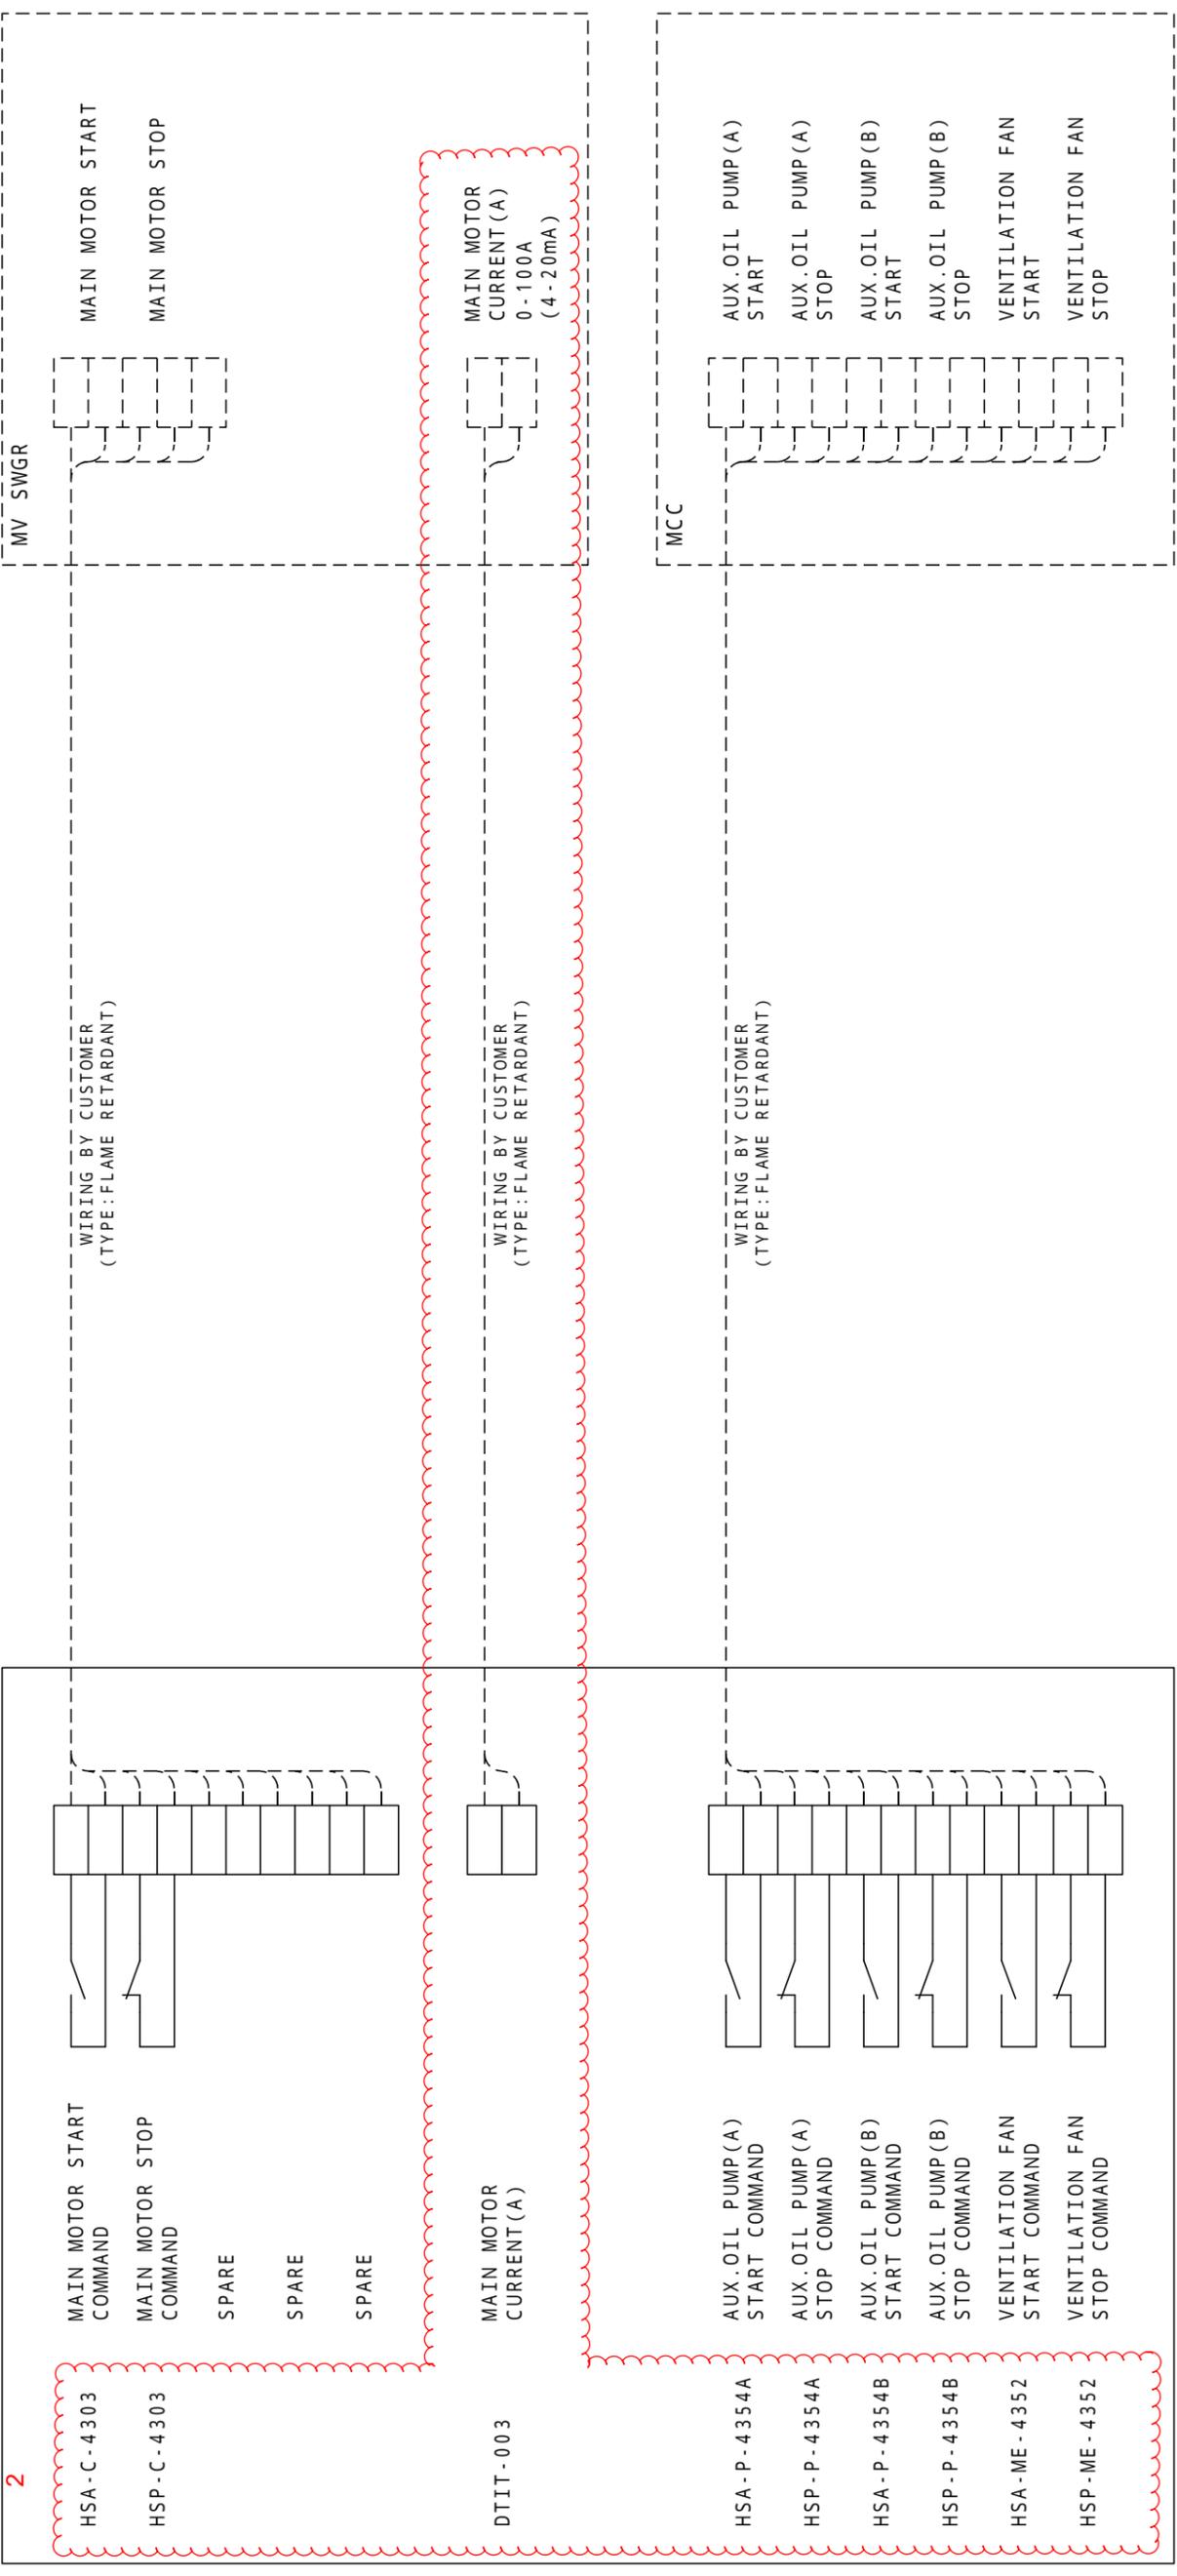

REVISION		REMARKS		TITLE		NO.	
R1		R4		OFF GAS COMPRESSOR		16	
R2		R5		WIRING CONNECTION DIAGRAM		PAGE	REV.
R3		R6					
				KOBE STEEL, LTD. Machinery Business			
				N.O.V.: 図面#18 回轉機#1800432KY B2WCA256 P. 16			

A B C D E F G H I J K L M N O P Q R P. CONFIDENTIAL

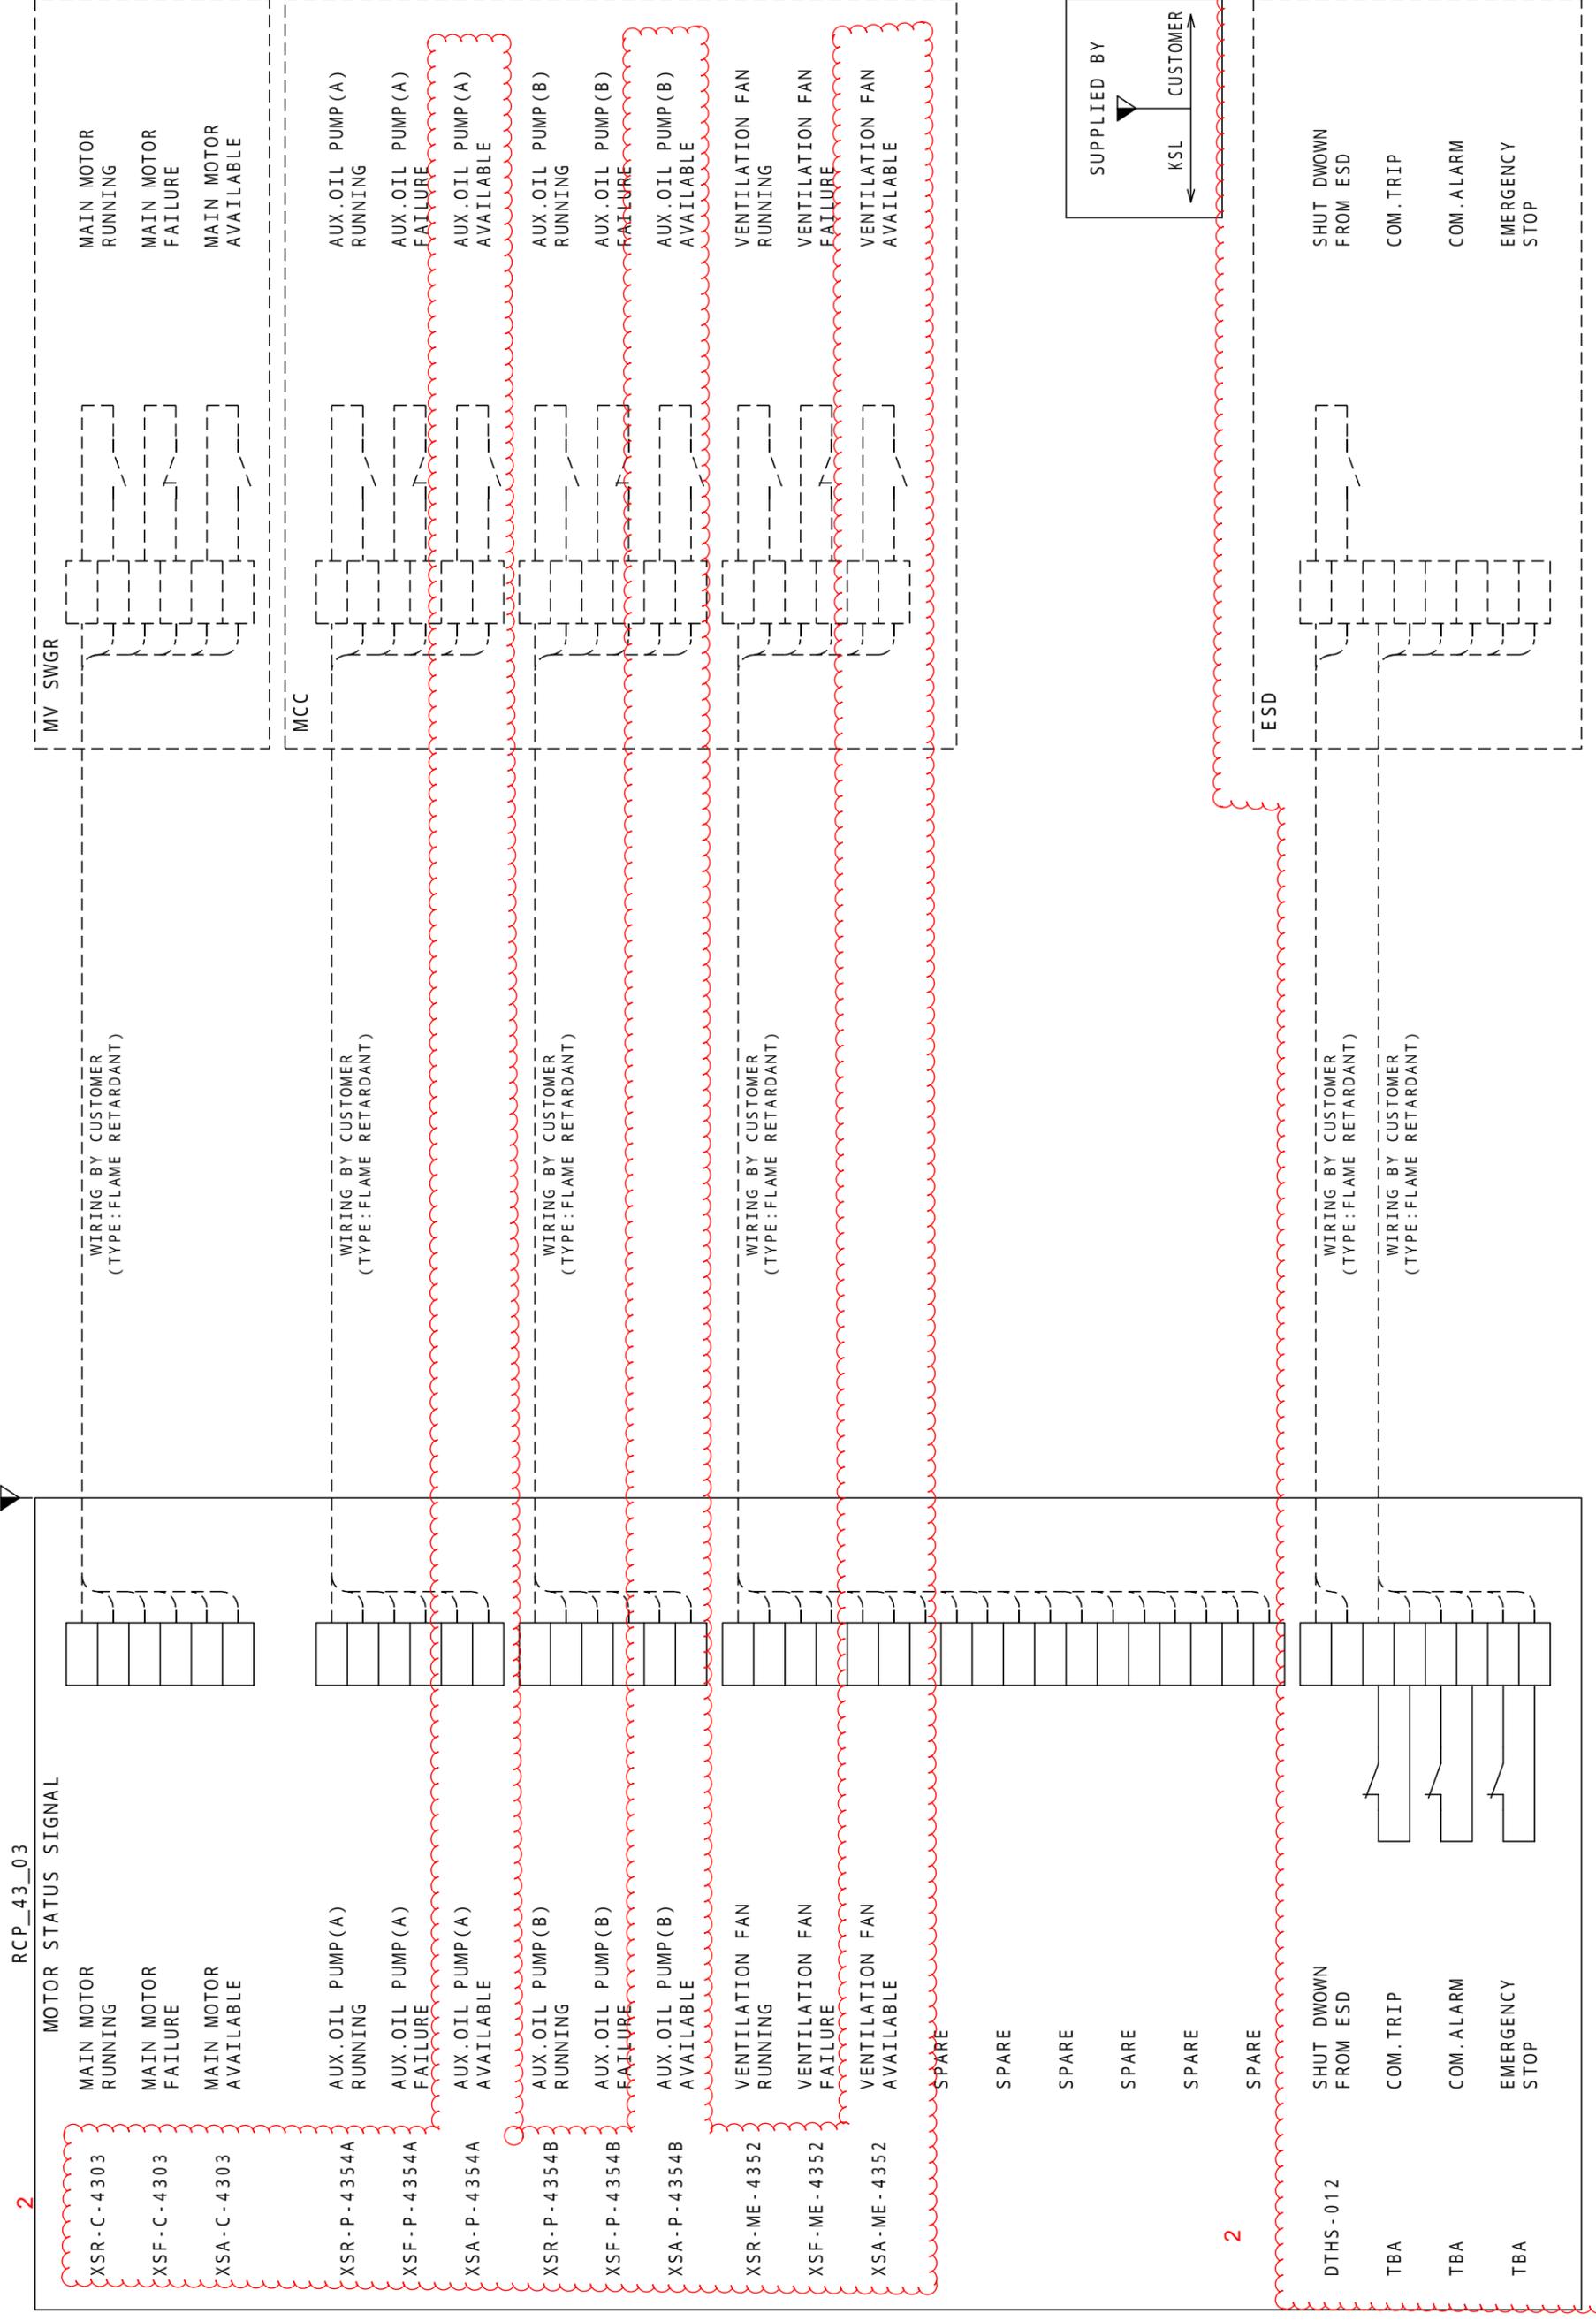


REVISION	R1	R2	R3	R4	R5	R6
REMARKS						
<p style="text-align: center;">KOBELCO KOBE STEEL, LTD. Machinery Business</p>						
OFF GAS COMPRESSOR						
WIRING CONNECTION DIAGRAM						
DATE						17
PAGE						17
REV.						

CONFIDENTIAL


2 LCP_43_03

2 UPS

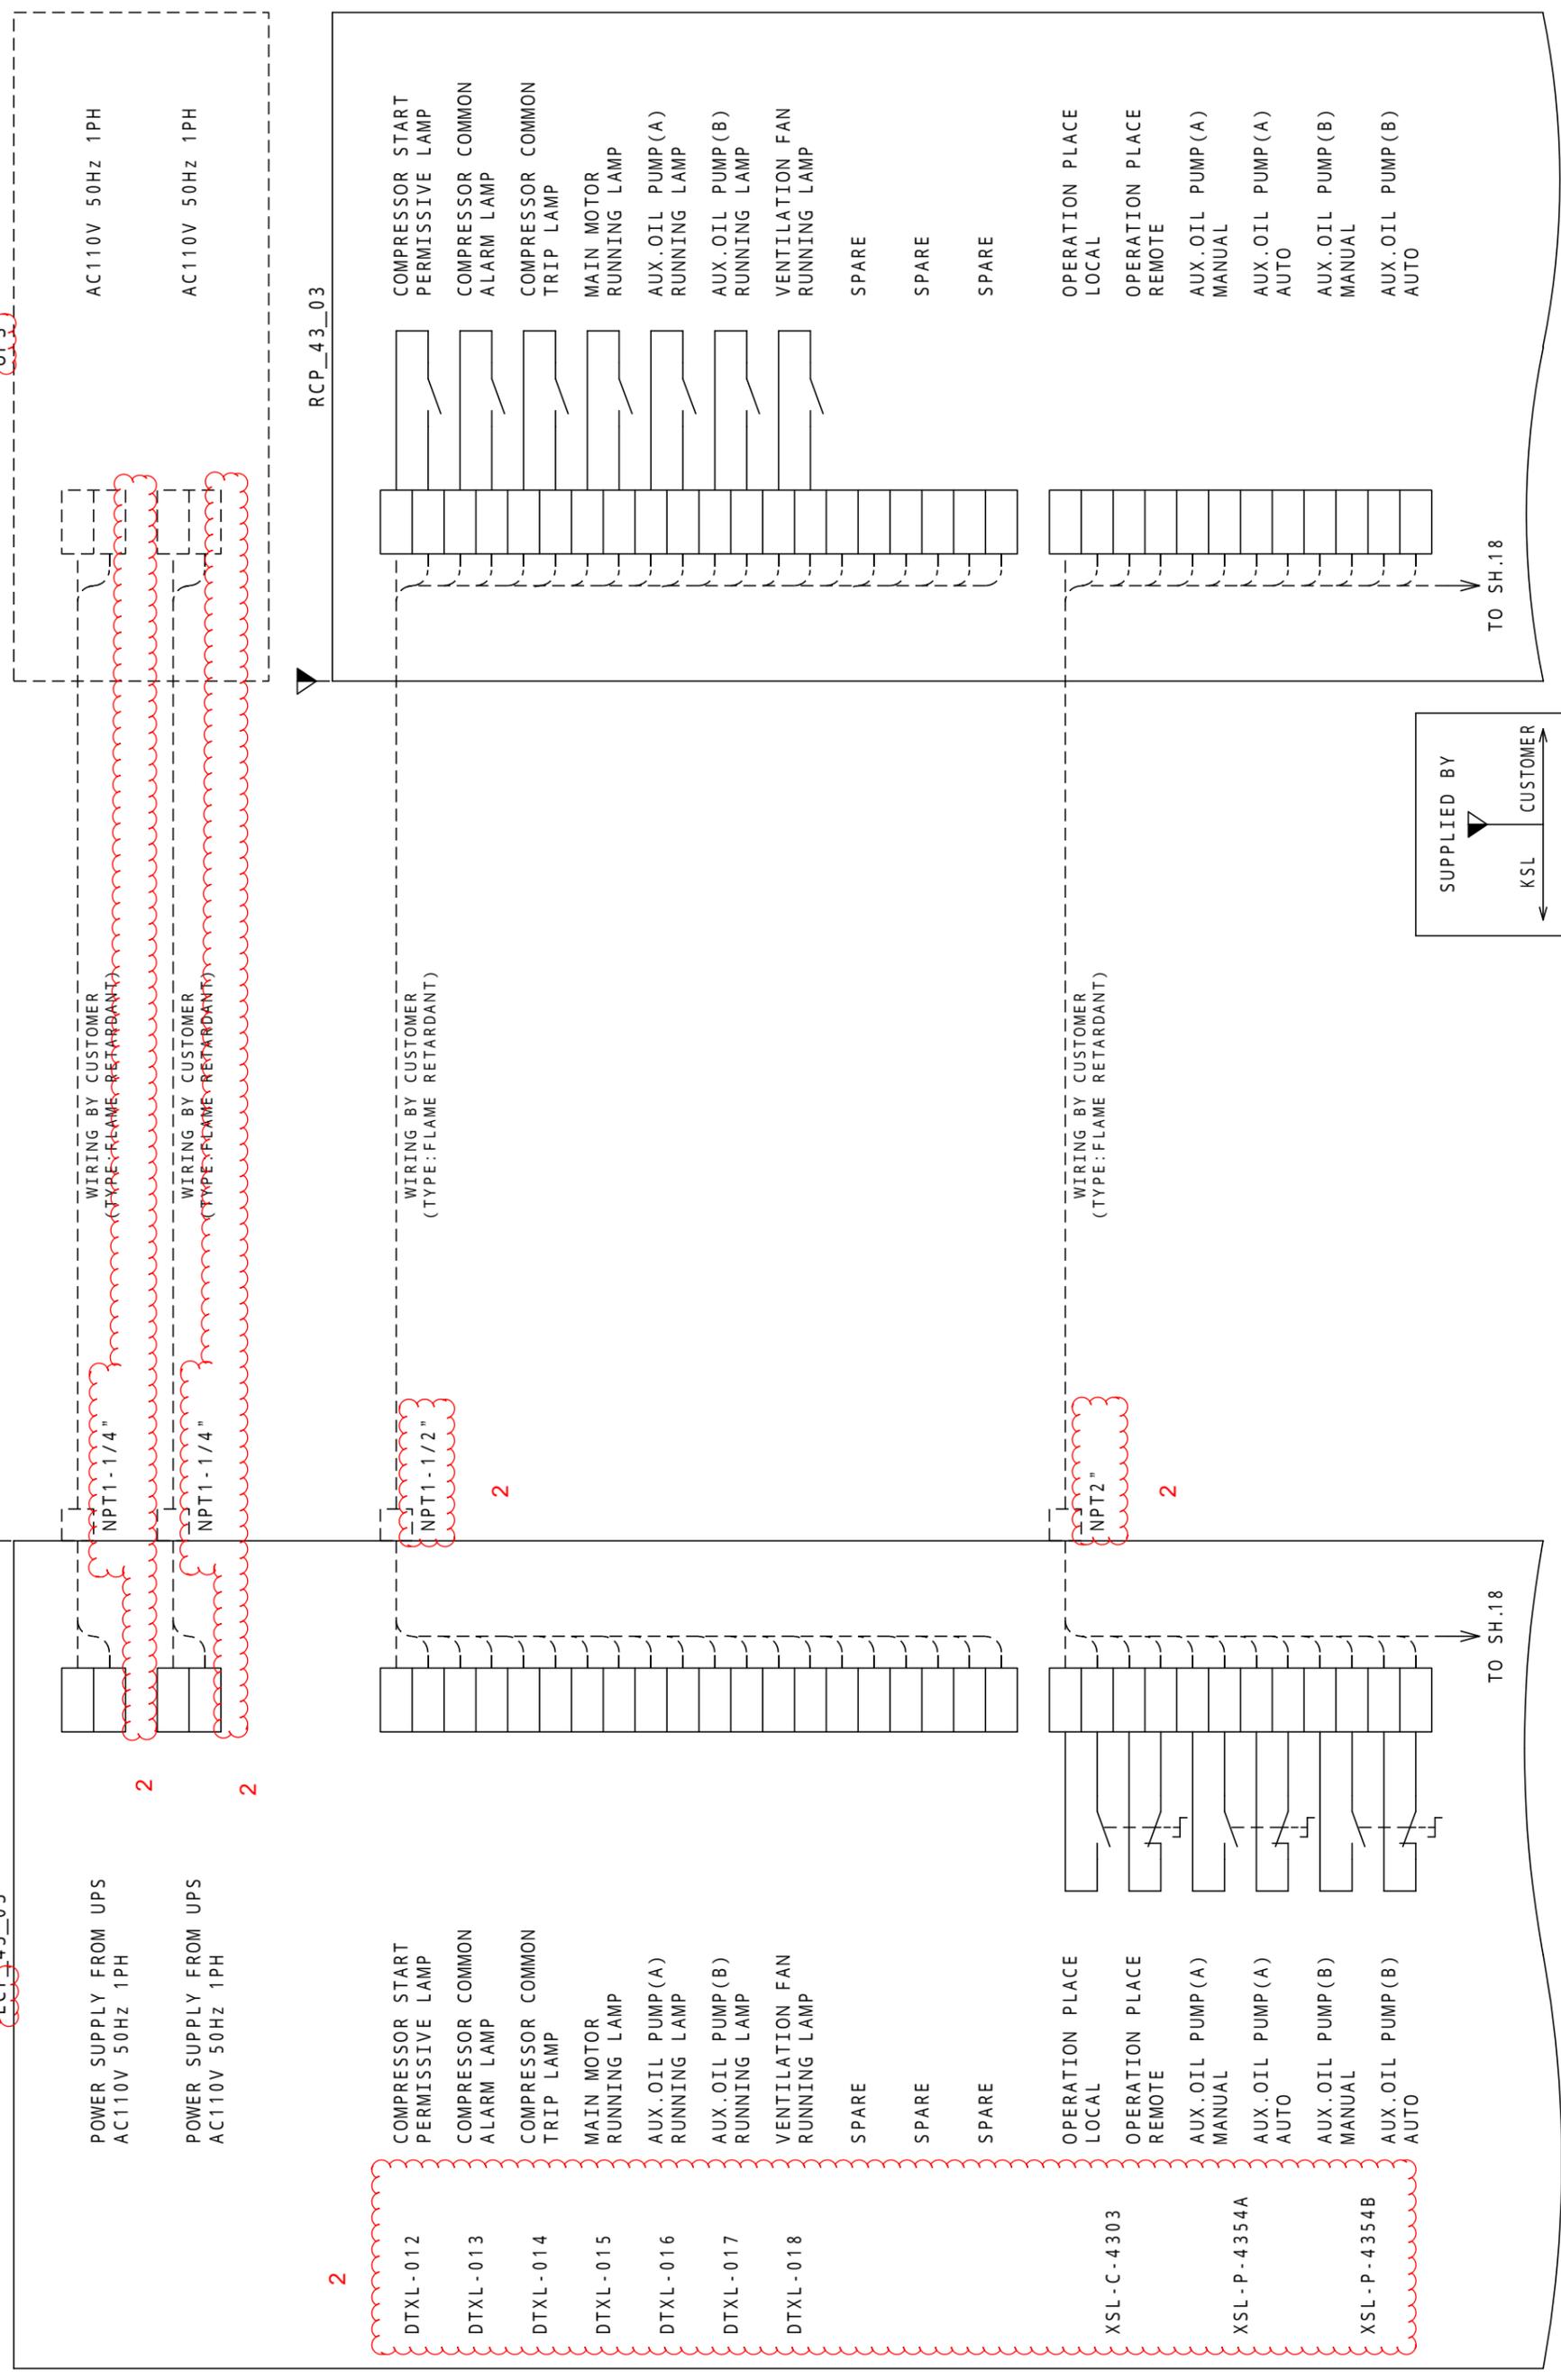

REVISION	R1	R4	R5	R6	REMARKS	TITLE KOBELCO KOBE STEEL, LTD. Machinery Business	OFF GAS COMPRESSOR WIRING CONNECTION DIAGRAM	NO.	18
	R2							PAGE	18
	R3							REV.	

P. CONFIDENTIAL Q P P O N M L K J I H G F E D C B A



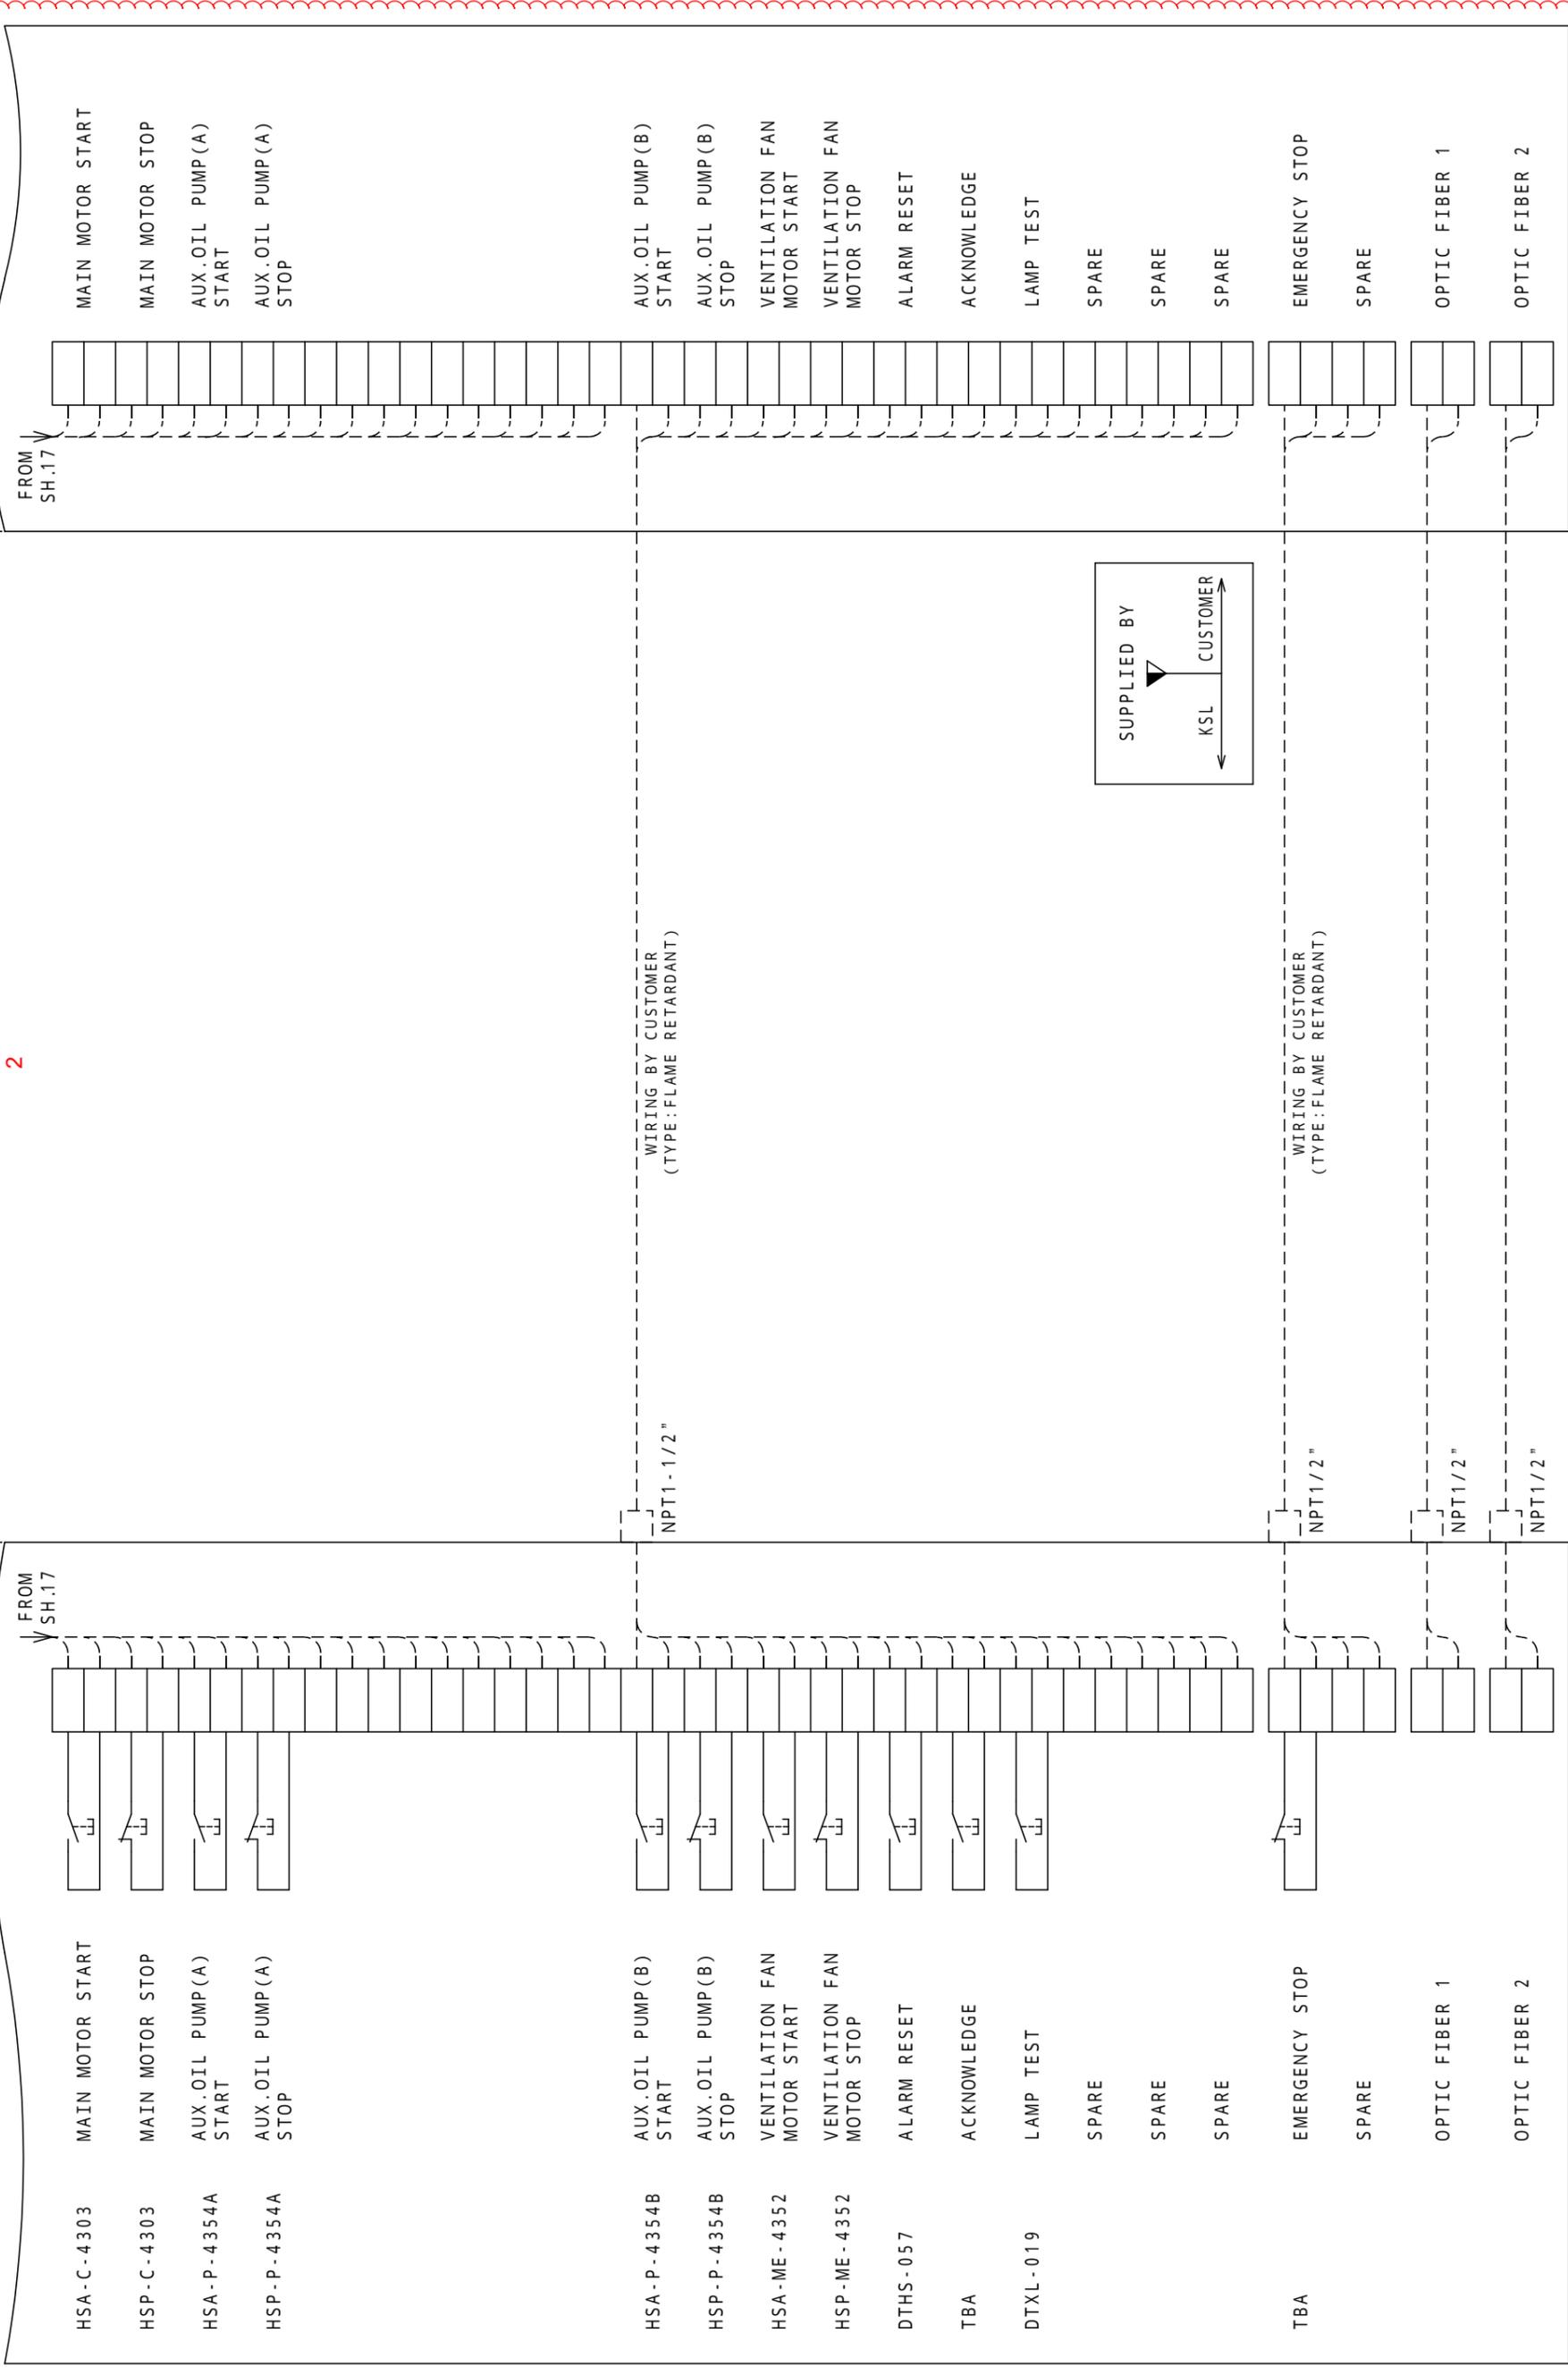


2

REVISION	R1	R2	R3	R4	R5	R6
REMARKS						
TITLE						
OFF GAS COMPRESSOR						
WIRING CONNECTION DIAGRAM						
NO. 19						
PAGE						
REV.						
KOBELCO						
KOBELCO, LTD.						
Machinery Business						
No. V: 煙面#18 煙面機#1800432KV B2WCA256 P. 19						

A B C D E F G H I J K L M N O P Q R CONFIDENTIAL

2 Page add

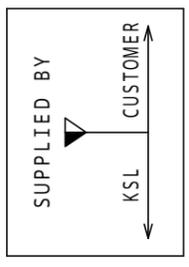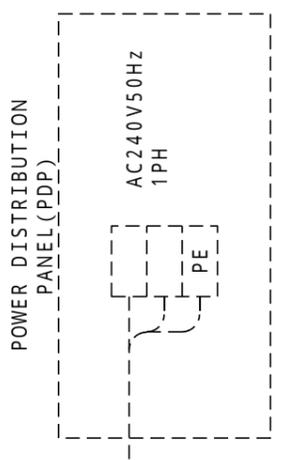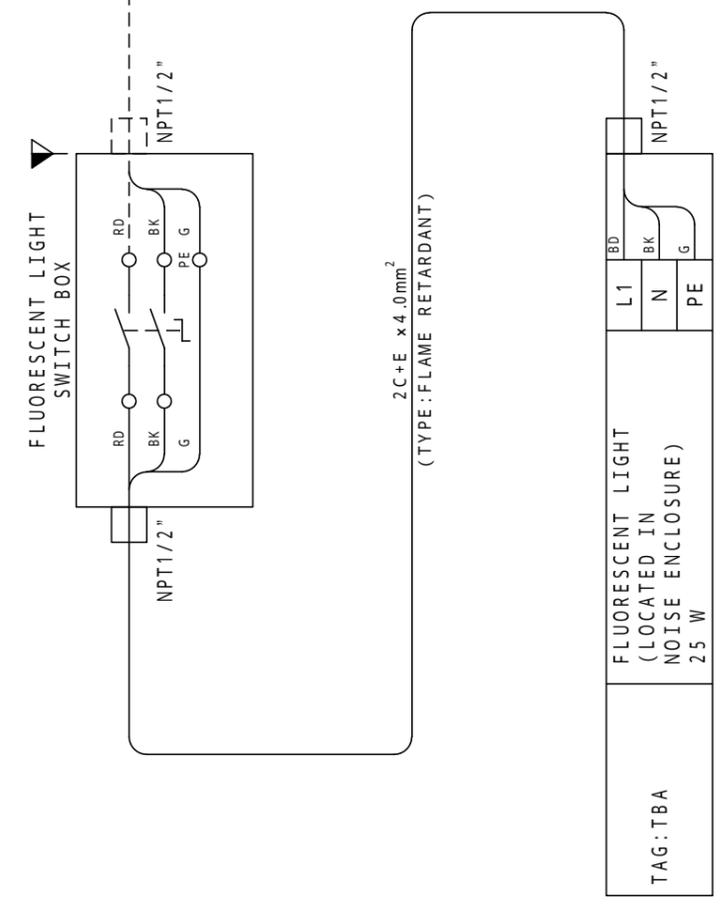

(NOTE) — (FULL LINE) : KSL SUPPLY & WORKS
 --- (DASHED LINE) : CUSTOMER SUPPLY & WORKS

REVISION	R1					KOBELCO Machinery Business KOBE STEEL, LTD.	TITLE OFF GAS COMPRESSOR WIRING CONNECTION DIAGRAM	NO.	20
	R2							PAGE	
	R3							REV.	